

RECEIVED
MAY 5 1958

STATE ENGINEER
SALEM, OREGON

Registration No. GR - 1544

Certificate No. GR - 1487

Registration Statement

OF CLAIMANT OF RIGHT TO APPROPRIATE GROUND WATER

TO THE STATE ENGINEER OF OREGON:

I, Elmer H. Wallin

of Route 1, Box 221, Central Point, Oregon County of Jackson
(Mailing address)

State of Oregon, do hereby make application for a certificate of registration as evidence of a right to appropriate ground water.

1. Source from which water is withdrawn is sump--(infiltration trench)
(Flowing well, pump well, infiltration trench, or tunnel)

2. Location is: 1 1/2 miles west of Central Point
(Approximate distance and direction from nearest city or town)

and is more particularly described as follows:

(a) 1765 feet south and 520 feet west from the NE corner, Dig #45
(Give distance and bearing to corner of section or other legal subdivision)

being within NE 1/4 NE 1/4 NW 1/4 of Sec. 9, Twp. 37 S., Rge. 2 W.
(Smallest legal subdivision) (N. or S.) (E. or W.)

or (b) within limits of recorded platted property, town or city:

in Lot _____, Block _____ of _____
(Name of plat or addition)

County of _____
(If within city or town, give name)

3. Construction Work was begun on 1920; was completed on 1946
(Date) (Date)

and the ground water claimed was first used for the purposes set out below on 1920
(Date)

since which time the water has been used continuously
(Continuously or intermittently)

from 1920 to 1958
(Date) (Date)

4. Quantity of water claimed and used is 115 gallons per minute; 53 acre feet per year.

5. Purpose or Purposes for which water is used : irrigation

(Domestic, irrigation, municipal, manufacturing, industrial, etc.)

See Item 11 Description of Well: Depth 7 feet. Type dug
(Dug or drilled)

diameter 15.0" x 30" Elevation of ground at well site 1270 feet, mean sea level.
(As near as known)

Depth to water table 3.0 feet.

7. Capacity of Well: 115 g.p.m. with 1 1/2 ft. per hour feet drawdown.
_____ g.p.m. with _____ feet drawdown.

Date of test none - noted from use.

If Flowing Well: Measured discharge _____ g.p.m. on _____
(Date)

Shut-in pressure at ground surface _____ lbs. per sq. in. on _____
(Date)

Water is controlled by _____
(Cap, valve, etc.)

8. Casing: (Give diameter, commercial specifications and depth below ground surface of each casing size.)

..... inch diameter none from to feet

..... inch diameter from to feet

..... inch diameter from to feet

..... inch diameter from to feet

Describe and show depth of shoe, plug, adapter, liner or other details:

.....

.....

9. Perforated Casings or Screens:

..... none from to

(Number per foot and size of perforations, or describe screen)

..... from to

..... from to

..... from to

10. Log of Well: (Describe each stratum or formation clearly, indicate if water bearing, and give thickness and depth as indicated.)

MATERIAL	Thickness (Feet)	Depth to Bottom (Feet)
Granite sandy loam (water bearing)	3.0	4.0
Yellow and blue clay	2.0	2.0
Sandstone	2.0	0

If log of well is not available, give name and address of driller. _____

11. Infiltration Trench: Covered or open open

Dimensions: Length 150 ft. Minimum depth 5 ft. Maximum depth 7 ft.

Bottom width 30 ft. Discharge _____ g.p.m. Date of test none

12. Tunnel: Type of lining _____

Dimensions: _____
(Length, course, and cross sectional size)

Position of water bearing stratum with reference to portal of tunnel _____

Log of tunnel: (Preceding table for log of well may be used, if desired. Give footage from portal and character of materials, as pertinent.)

13. Pumping Equipment:

(a) Pump 2.0 inch centrifugal pump (Jaeger) Capacity 115 g.p.m.
(Make, type and size)


(b) Motor 5.0 H.P. gasoline engine (Wisc.)
(Type and horsepower)

14. Location of area irrigated or to be irrigated, or place of use if for purposes other than irrigation.

Township North or South	Range E. or W. of Willamette Meridian	Section	Four-Corner Tract	Number Acres To Be Irrigated	Date of Reclamation
37 S.	2 W.	4	SE $\frac{1}{4}$ NE $\frac{1}{4}$ SW $\frac{1}{4}$	1.4 acres	1920
"	"	4	E $\frac{1}{2}$ SE $\frac{1}{4}$ SW $\frac{1}{4}$	5.5 acres	1920
"	"	4	SW $\frac{1}{4}$ NW $\frac{1}{4}$ SE $\frac{1}{4}$	1.2 acres	1920
"	"	4	W $\frac{1}{2}$ SW $\frac{1}{4}$ SE $\frac{1}{4}$	2.5 acres	1920
"	"	9	NE $\frac{1}{4}$ NE $\frac{1}{4}$ NW $\frac{1}{4}$	0.5 acre	1920
"	"	9	NW $\frac{1}{4}$ NW $\frac{1}{4}$ NE $\frac{1}{4}$	0.6 acre	1920
				11.7 acres	

15. If the ground water supply is supplemental to an existing water supply, identification of any application for a permit, permit, certificate or adjudicated right to appropriate water made or held by the registrant none

Township 37 S. Range 2 W., W.M.

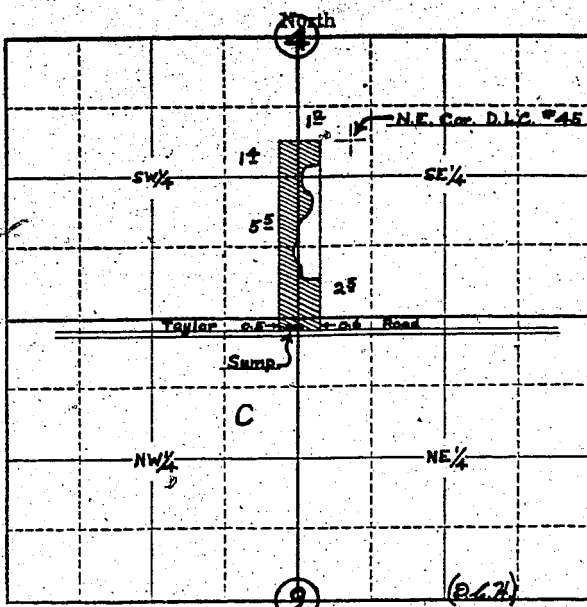

Locate well and acreage of irrigated land on plat.

Scale: 4" - 1 Mile

STATE OF OREGON

County of Jackson

} ss.

I, Elmer H. Wallin, being first duly sworn, do hereby certify that I have read the foregoing Registration Statement and that all of the items therein contained are true to the best of my knowledge and belief.

Elmer H. Wallin
(Signature of Registrant)

Subscribed and sworn to before me this 2nd day of May, 1958

My commission expires Nov. 23-1960

Myra H. Hill
(Notary Public for Oregon)

(SEAL)

CERTIFICATE OF REGISTRATION

STATE OF OREGON

County of Marion

} ss.

This is to certify that the foregoing Registration Statement was received in the office of the State Engineer on the 5th day of May, 1958, at 8:00 o'clock A. M. and has been duly recorded in said office in Book No. 7 of Registration Statements on page GR-1487

Witness my hand this 1st day of December, 1958

Laura A. Stanley
(State Engineer)

By _____ (Deputy)

GR - 1487

7/1500