

RECEIVED
MAY 5-1958

Registration No. GR. - 1516

Certificate No. GR. - 1489

STATE ENGINEER
SALEM, OREGON

Registration Statement

OF CLAIMANT OF RIGHT TO APPROPRIATE GROUND WATER

TO THE STATE ENGINEER OF OREGON:

I, John Dudley Nelson
of Junction City Ore. RA3 County of Lane
(Mailing address)

State of Oregon, do hereby make application for a certificate of registration as evidence of a right to appropriate ground water.

1. Source from which water is withdrawn is Pump well
(Flowing well, pump well, infiltration trench, or tunnel).
2. Location is: 4 1/2 Miles North of Junction City
(Approximate distance and direction from nearest city or town)

and is more particularly described as follows:

(a) 2970 feet North of Section corner, 1/2 mile west
(Give distance and bearing to corner of section or other legal subdivision)

being within SE 1/4 of N.E. 1/4 of Sec. 18, Twp. 15 S, Rge. 4 W
(Smallest legal subdivision) (N. or S.) (E. or W.)

or (b) within limits of recorded platted property, town or city:

in Lot _____, Block _____ of _____
(Name of plat or addition)

County of _____
(If within city or town, give name)

3. Construction Work was begun on Aug. 20, 1948; was completed on Aug. 21, 1948
(Date) (Date)

and the ground water claimed was first used for the purposes set out below on Aug. 1948
(Date)

since which time the water has been used Intermittently
(Continuously or Intermittently)

from Aug. 1948 to Sept. 1957
(Date) (Date)

4. Quantity of water claimed and used is 400 gallons per minute; 3 1/2 acre feet per year.

5. Purpose or Purposes for which water is used Irrigation
(Domestic, irrigation, municipal, manufacturing, industrial, etc.)

6. Description of Well: Depth 21 feet. Type Driven
(Dug or drilled)

diameter 4 inches. Elevation of ground at well site 200 feet, mean sea level.
(As near as known)

Depth to water table 9 feet.

7. Capacity of Well: 500 g.p.m. with None feet drawdown.

_____ g.p.m. with _____ feet drawdown.


Date of test Aug. 21, 1948

If Flowing Well: Measured discharge _____ g.p.m. on _____
(Date)

Shut-in pressure at ground surface _____ lbs. per sq. in. on _____
(Date)

Water is controlled by _____
(Cap, valve, etc.)

Township 15S Range 4W, W.M.
North

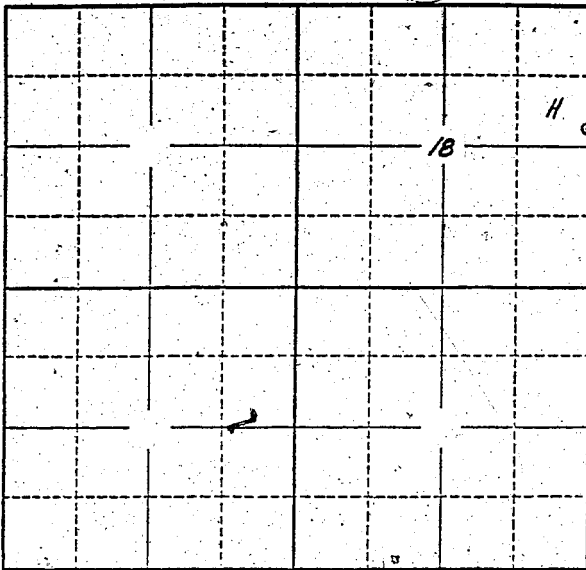

Locate well and acreage of irrigated land on plat.
Scale: 2" = 1 Mile

STATE OF OREGON

County of Linn } ss.

I, JOHN DUDLEY NELSON, being first duly sworn, do hereby certify that I have read the foregoing Registration Statement and that all of the items therein contained are true to the best of my knowledge and belief.

John Dudley Nelson
(Signature of Registrant)

Subscribed and sworn to before me this 26th day of April, 1958

My commission expires 8-10-59

Ray John
(Notary Public)

(SEAL)

CERTIFICATE OF REGISTRATION

STATE OF OREGON

County of Marion } ss.

This is to certify that the foregoing Registration Statement was received in the office of the State Engineer on the 5th day of May, 1958, at 8.00 o'clock A. M. and has been duly recorded in said office in Book No. 7 of Registration Statements on page GR-1489

Witness my hand this 1st day of December, 1958

Lewis A. Stanley
(State Engineer)

By _____
(Deputy)

#1500