

RECEIVED  
MAY 6 1958

STATE ENGINEER  
SALEM, OREGON

Registration No. GR - 1518

Certificate No. GR - 1493

# Registration Statement

## OF CLAIMANT OF RIGHT TO APPROPRIATE GROUND WATER

TO THE STATE ENGINEER OF OREGON:

<sup>1800</sup>  
~~HERMAN KUNKEL~~  
I, Herman Kunkel

of 765 River Road Junction City County of Linn  
(Mailing address)

State of Oregon, do hereby make application for a certificate of registration as evidence of a right to appropriate ground water.

1. Source from which water is withdrawn is Private well  
(Flowing well, pump well, infiltration trench, or tunnel)

2. Location is: EAST 1/2 mile of Junction City on River Road  
(Approximate distance and direction from nearest city or town)

and is more particularly described as follows:

(a) ~~1377 ft~~ 15 1/2 Ch. S and 2.8 1/2 Ch. E from NW Cor of Sec 4  
(Give distance and bearing to corner of section or other legal subdivision)

being within NE 1/4 NW 1/4 of Sec. 4, Twp. 16 S, Rge. 4 W.  
(Smallest legal subdivision) (N. or S.) (E. or W.)

or (b) within limits of recorded platted property, town or city:

in Lot \_\_\_\_\_, Block \_\_\_\_\_ of \_\_\_\_\_  
(Name of plat or addition)

County of \_\_\_\_\_  
(If within city or town, give name)

3. Construction Work was begun on April 1-1948 was completed on April 15-1948  
(Date) (Date)

and the ground water claimed was first used for the purposes set out below on 1948  
(Date)

since which time the water has been used intermittently  
(Continuously or intermittently)

from May 1 to Oct 1  
(Date) (Date)

4. Quantity of water claimed and used is 400 gallons per minute; 125 acre feet per year.

5. Purpose or Purposes for which water is used Pasture irrigation  
(Domestic, irrigation, municipal, manufacturing, industrial, etc.)

6. Description of Well: Depth 28 feet. Type Drilled Driven  
(Dug or drilled)

diameter 5 inches. Elevation of ground at well site 4 feet, mean sea level.  
(As near as known)

Depth to water table 18 feet.

7. Capacity of Well: \_\_\_\_\_ g.p.m. with \_\_\_\_\_ feet drawdown.

\_\_\_\_\_ g.p.m. with \_\_\_\_\_ feet drawdown.

Date of test NOV

If Flowing Well: Measured discharge \_\_\_\_\_ g.p.m. on \_\_\_\_\_  
(Date)

Shut-in pressure at ground surface \_\_\_\_\_ lbs. per sq. in. on \_\_\_\_\_  
(Date)

Water is controlled by \_\_\_\_\_  
(Cap. valve, etc.)

8. Casing: (Give diameter, commercial specifications and depth below ground surface of each casing size.)

5 inch diameter ..... from 2 to 28 feet  
 ..... inch diameter ..... from ..... to ..... feet  
 ..... inch diameter ..... from ..... to ..... feet  
 ..... inch diameter ..... from ..... to ..... feet

Describe and show depth of shoe, plug, adapter, liner or other details: .....

.....

.....

9. Perforated Casings or Screens:

(Number per foot and size of perforations, or describe screen) ..... from ..... to .....

Perforated casing ..... from 5 to 7 ft

..... from ..... to .....


..... from ..... to .....

10. Log of Well: (Describe each stratum or formation clearly, indicate if water bearing, and give thickness and depth as indicated.)

MATERIAL	Thickness (Feet)	Depth to Bottom (Feet)
Not known		



Township 16S Range 4W, W.M.  
North

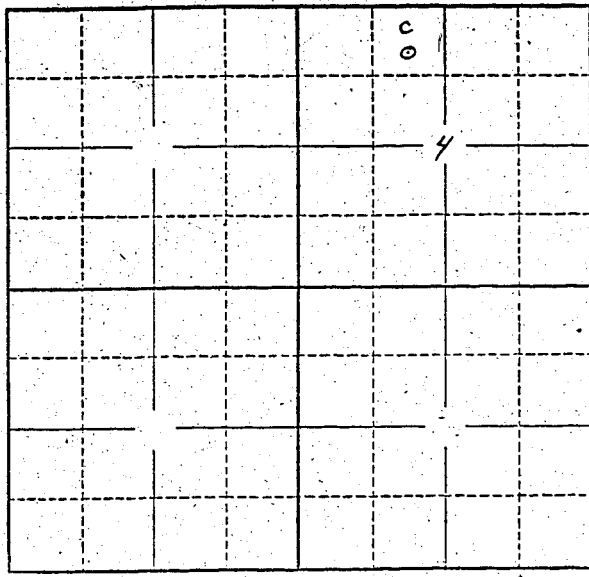

Locate well and acreage of irrigated land on plat.  
Scale: 2" = 1 Mile

STATE OF OREGON }  
County of Polk } ss.

I, HERMAN KUNKEL, being first duly sworn, do hereby certify that I have read the foregoing Registration Statement and that all of the items therein contained are true to the best of my knowledge and belief.

Herman Kunkel  
(Signature of Registrant)


(Notary Public)

(SEAL)

**CERTIFICATE OF REGISTRATION**

STATE OF OREGON }  
County of Marion } ss.



Lewis A. ...  
(State Engineer)

By ...  
(Deputy)

18.00