

RECEIVED  
MAY 11 1958  
STATE ENGINEER  
SALEM, OREGON

REGISTRATION NO. GR-1519  
CERTIFICATE NO. GR-1567

# Registration Statement

## OF CLAIMANT OF RIGHT TO APPROPRIATE GROUND WATER

(Under Chapter 708, Oregon Laws 1955.)

TO THE STATE ENGINEER OF OREGON:

I, Albert F. and Roy A. DeCrevel  
of Rt. 2 Box 35 Yamhill County of Yamhill  
State of Oregon, do hereby make application for a certificate of registration as evidence  
of a right to appropriate ground water.

1. Source from which water is withdrawn is Pump Well  
(Flowing well, pump well, infiltration trench, or tunnel)

2. Location is: 2 Miles East 1/2 Miles North from Yamhill  
(Approximate distance and direction from nearest city or town)

and is more particularly described as follows: Well # 1

(a) 232 ft. E. 191 Ft. N. of the N.E. Cor. of the R. R. Laughlin D.L.C.  
(Give distance and bearing to corner of section or other legal subdivision)

being within NW<sup>1</sup> of the SW<sup>2</sup> of Sec. 35, Twp. 2 S, Rge. 1 W  
(Smallest legal subdivision) (or S.) (E or W.)

or (b) within limits of recorded platted property, town or city:

in Lot \_\_\_\_\_, Block \_\_\_\_\_ of \_\_\_\_\_  
(Name of plat or addition)

County of Yamhill  
(If within city or town, give name)

3. Construction Work was begun on Fall of 1952; was completed on Fall of 1952  
(Date) (Date)

and the ground water claimed was first used for the purposes set out below on Fall of 1952  
(Date)

since which time the water has been used Continuously  
(Continuously or Intermittently)

from Fall of 1952 to 1958  
(Date) (Date)

4. Quantity of water claimed and used is 20 gallons per minute; \_\_\_\_\_ acre  
feet per year.

5. Purpose or Purposes for which water is used Domestic and Irrigation

(Domestic, irrigation, municipal, manufacturing, industrial, etc.)

6. Description of Well: Depth 65 feet. Type Drilled  
(Dug or drilled)

diameter 8 inches. Elevation of ground at well site 300 feet, mean sea level.  
(As near as known)

Depth to water table 20 feet.

7. Capacity of Well: 30 g.p.m. with Don't know feet drawdown.

\_\_\_\_\_ g.p.m. with \_\_\_\_\_ feet drawdown.

Date of test Fall of 1952

If Flowing Well: Measured discharge \_\_\_\_\_ g.p.m. on \_\_\_\_\_  
(Date)


Shut-in pressure at ground surface \_\_\_\_\_ lbs. per sq. in. on \_\_\_\_\_  
(Date)

Water is controlled by \_\_\_\_\_  
(Cap, valve, etc.)





Township 25 Range 4W W.M.  
North

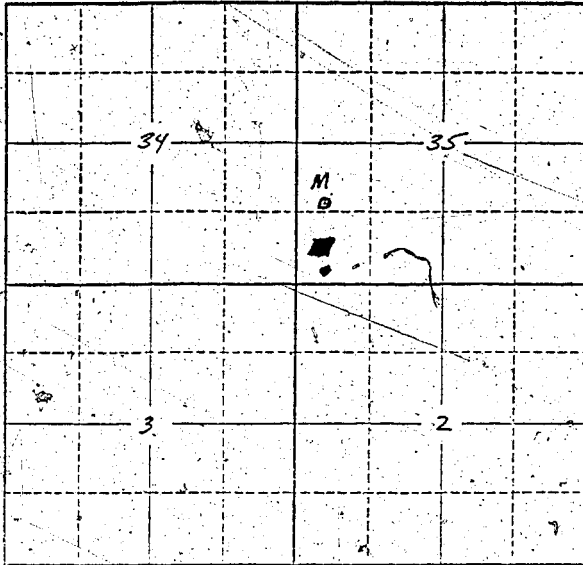

Locate well and acreage of irrigated land on plat.  
Scale: 2" = 1 Mile

STATE OF OREGON

County of Yamhill } ss.

I, Albert F. DeCrevel being first duly sworn, do hereby certify that I have read the foregoing Registration Statement and that all of the items therein contained are true to the best of my knowledge and belief.

(Signature of Registrant)

Subscribed and sworn to before me this 3rd day of May, 1958

My commission expires NOTARY PUBLIC FOR OREGON  
May 1, 1959

X [Signature]  
(Notary Public)

(SEAL)

**CERTIFICATE OF REGISTRATION**

STATE OF OREGON

County of Marion } ss.

This is to certify that the foregoing Registration Statement was received in the office of the State Engineer on the 6th day of May, 1958, at 8<sup>00</sup> o'clock A.M. and has been duly recorded in said office in Book No. 7 of Registration Statements on page GR-1567

~~Construction shall be completed by \_\_\_\_\_ and the water completely applied to the land used by \_\_\_\_\_~~

Witness my hand this 1st day of December, 1958

[Signature]  
(State Engineer)

By \_\_\_\_\_ (Deputy)

GR-1567

\$15.00

N