

RECEIVED
MAY 7 1958
STATE ENGINEER
SALEM, OREGON

Registration No. GR 1553
Certificate No. GR 1497

Registration Statement

OF CLAIMANT OF RIGHT TO APPROPRIATE GROUND WATER

TO THE STATE ENGINEER OF OREGON:

I, Ronald E. Jones
of P. O. Box 98, Brooks County of Marion
(Mailing address)
State of Oregon, do hereby make application for a certificate of registration as evidence of a right to appropriate ground water.

1. Source from which water is withdrawn is Pump Well
(Flowing well, pump well, infiltration trench, or tunnel)

2. Location is: 3 miles Southeast of Brooks
(Approximate distance and direction from nearest city or town)

and is more particularly described as follows: 11.428 chains E. and 25.744 chains N. 29° 13' E. and 6.10 chains S. 78° 20' W. and 14.865 chains S. 74° 21' E. and 34.59 chains S. 4' E. and

(a) 0.11 chains West from the N.E. corner of the N. Lorran D. L. S. #71
(Give distance and bearing to corner of section or other legal subdivision)
being within N.W. 1/4 of S.E. 1/4 of Sec. 29 Twp. 6-S Rge. 2-W
(Smallest legal subdivision) (N. or S.) (E. or W.)

or (b) within limits of recorded platted property, town or city:

in Lot _____, Block _____ of _____
(Name of plat or addition)

_____ County of _____
(If within city or town, give name)

3. Construction Work was begun on 1945; was completed on 1946
(Date) (Date)

and the ground water claimed was first used for the purposes set out below on 1946
(Date)

since which time the water has been used Intermittently
(Continuously or Intermittently)

from April to September
(Date) (Date)

4. Quantity of water claimed and used is 600 gallons per minute; _____ acre feet per year.

5. Purpose or Purposes for which water is used Irrigation

(Domestic, irrigation, municipal, manufacturing, industrial, etc.)

6. Description of Well: Depth 125 feet. Type Drilled
(Dug or drilled)
diameter 12 inches. Elevation of ground at well site 190 feet, mean sea level.
(As near as known)

Depth to water table 10 feet.

7. Capacity of Well: 600 g.p.m. with 4 feet drawdown.
_____ g.p.m. with _____ feet drawdown.


Date of test 1946

If Flowing Well: Measured discharge _____ g.p.m. on _____
(Date)

Shut-in pressure at ground surface _____ lbs. per sq. in. on _____
(Date)

Water is controlled by _____
(Cap, valve, etc.)

Township 6-S Range 2-1, W.M.
North

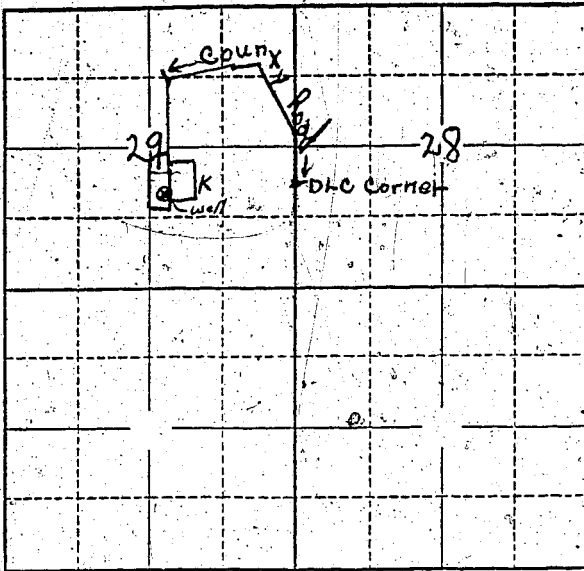

Locate well and acreage of irrigated land on plat.
Scale: 2" = 1 Mile

STATE OF OREGON
County of Larion } ss.

I, Ronald E. Jones, being first duly sworn, do hereby certify that I have read the foregoing Registration Statement and that all of the items therein contained are true to the best of my knowledge and belief.

Ronald E. Jones
(Signature of Registrant)

Subscribed and sworn to before me this 6th day of May, 1958.

My commission expires Oct. 25, 1958

Renee A. Basler
(Notary Public)

(SEAL)

CERTIFICATE OF REGISTRATION

STATE OF OREGON } ss.
County of Máron

This is to certify that the foregoing Registration Statement was received in the office of the State Engineer on the 7th day of May, 1958, at 8:00 o'clock A. M. and has been duly recorded in said office in Book No. 7 of Registration Statements on page GR-1497

Witness my hand this 1st day of December, 1958

Flewis A. [Signature]
(State Engineer)

By _____
(Deputy)

GR - 1497