

RECEIVED  
APR 11 1958

REGISTRATION NO. GR-1554

STATE ENGINEER  
SALEM, OREGON

Registration Statement CERTIFICATE NO. GR-1498

OF CLAIMANT OF RIGHT TO APPROPRIATE GROUND WATER

(Under Chapter 708, Oregon Laws 1955.)

TO THE STATE ENGINEER OF OREGON:

I, CASCADE MEATS, INC.

of Salem County of Marion

State of Oregon, do hereby make application for a certificate of registration as evidence of a right to appropriate ground water.

1. Source from which water is withdrawn is Pump Well #1  
(Flowing well, pump well, infiltration trench, or tunnel)

2. Location is: North Salem, Oregon  
(Approximate distance and direction from nearest city or town)

and is more particularly described as follows:

(a) 790 feet west & 2330 feet south from NE corner of Section 14  
(Give distance and bearing to corner of section or other legal subdivision)

being within SE 1/4 of NE 1/4 of Sec. 14 Twp. 7 S Rge. 3 W  
(Smallest legal subdivision) (N or S) (E or W)

or (b) within limits of recorded platted property, town or city:

in Lot 2, Block of Oregon's Addition  
(Name of plat or addition)

Salem County of Marion  
(If within city or town, give name)

3. Construction Work was begun on Nov. 14, 1948; was completed on Dec. 4, 1948  
(Date) (Date)

and the ground water claimed was first used for the purposes set out below on Dec. 15, 1948  
(Date)

since which time the water has been used continuously  
(Continuously or intermittently)

from Dec 15, 1948 to Present time  
(Date) (Date)

4. Quantity of water claimed and used is 250 gallons per minute;          acre feet per year.

5. Purpose or Purposes for which water is used

Industrial  
(Domestic, irrigation, municipal, manufacturing, industrial, etc.)

6. Description of Well: Depth 181 feet. Type Drilled  
(Dug or drilled)

diameter 12 inches. Elevation of ground at well site 150 feet, mean sea level.  
(As near as known)

Depth to water table 22 feet.

7. Capacity of Well: 250 g.p.m. with 30 feet drawdown.

500 g.p.m. with 80 feet drawdown.

Date of test December 15, 1948

If ~~Flowing~~ Well: Measured discharge 250 g.p.m. on Dec. 15, 1948  
(Date)

Shut-in pressure at ground surface 70 lbs. per sq. in. on Dec. 15, 1948  
(Date)

Water is controlled by Pressure Regulator  
(Cap, valve, etc.)

8. Casing: (Give diameter, commercial specifications and depth below ground surface of each casing size.)

12 inch diameter from 0 to 151 feet  
 inch diameter from to feet  
 inch diameter from to feet  
 inch diameter from to feet

Describe and show depth of shoe, plug, adapter, liner or other details:

9. Perforated Casings or Screens:


8 rows of perforations from 65' to 77'  
 (Number per foot and size of perforations, or describe screen)  
 8 rows of perforations from 123' to 128'  
 8 rows of perforations from 134' to 139'  
 8 rows of perforations from 141' to 151'

10. Log of Well: (Describe each stratum or formation clearly, indicate if water bearing, and give thickness and depth as indicated.)

Surface	to	MATERIAL	Thickness (Feet)	Depth to Bottom (Feet)
		18 ft. Topsoil and clay		
18 ft.	"	32 ft. Gravel with clay binder		
32 ft.	"	38 ft. Cemented Gravel		
39 ft.	"	43 ft. Loose sand and gravel		
43 ft.	"	49 ft. Loose sand and gravel - water bearing formation.		
49 ft.	"	62 ft. Cemented Gravel		
62 ft.	"	77 ft. Loose sand and gravel - water bearing formation.		
77 ft.	"	92 ft. Sand and Gravel - yellow clay binder		
93 ft.	"	121 ft. Gravel and Sand - Yellow clay binder		
121 ft.	"	127 ft. Loose sand and gravel - Water bearing formation.		
127 ft.	"	134 ft. Gravel and sand - clay binder		
134 ft.	"	151 ft. Loose sand and gravel - water bearing formation		
151 ft.	"	151 ft. Sand and gravel - clay binder		



Township 75 Range 3W, W.M.  
North

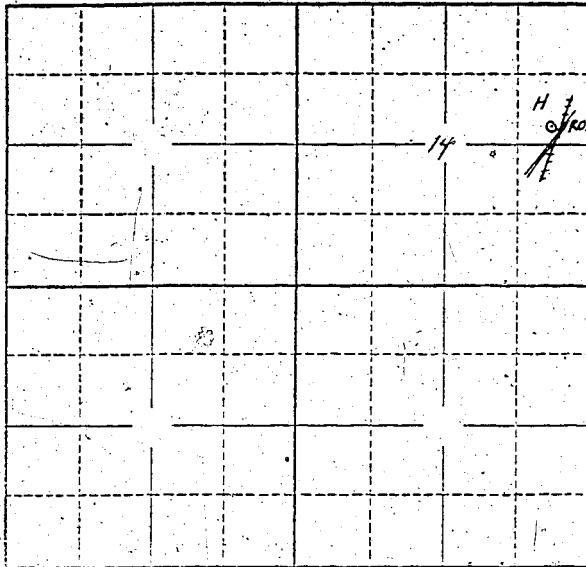

Locate well and acreage of irrigated land on plat.  
Scale: 2" = 1 Mile

STATE OF OREGON

County of Marion ss.

I, James R. Zigler, being first duly sworn, do hereby certify that I have read the foregoing Registration Statement and that all of the items therein contained are true to the best of my knowledge and belief.

Cascade Meats, Inc.

By: James R. Zigler  
(Signature of Registrant) Secretary-Treasurer

Subscribed and sworn to before me this 10th day of April, 1958.

My commission expires March 23, 1960  
Lewis W. Selmer  
(Notary Public)

(SEAL)

**CERTIFICATE OF REGISTRATION**

STATE OF OREGON

County of Marion ss.

This is to certify that the foregoing Registration Statement was received in the office of the State Engineer on the 7th day of May, 1958, at 2:15 o'clock P.M. and has been duly recorded in said office in Book No. 7 of Registration Statements on page GR-1498

~~Construction shall be completed by 10 and the water completely applied in beneficial use by 19~~

Witness my hand this 1st day of December, 1958

Lewis W. Selmer  
(State Engineer)

#2000

By \_\_\_\_\_ (Deputy)

GR-1498