

RECEIVED
MAY 9 1958
STATE ENGINEER
SALEM, OREGON

Registration No. GR. - 1557
Certificate No. GR. - 1501

Registration Statement

OF CLAIMANT OF RIGHT TO APPROPRIATE GROUND WATER

TO THE STATE ENGINEER OF OREGON:

I, Albert H. Puhl

of 4279 Table Rock Rd., Medford, Oregon County of Jackson
(Mailing address)

State of Oregon, do hereby make application for a certificate of registration as evidence of a right to appropriate ground water.

1. Source from which water is withdrawn is Infiltration trench
(Flowing well, pump well, infiltration trench, or tunnel)

2. Location is: 1 mile due west of Central Point
(Approximate distance and direction from nearest city or town)

and is more particularly described as follows:

(a) 290 feet South and 96 feet East from the NW corner DIC #57
(Give distance and bearing to corner of section or other legal subdivision)
being within SE $\frac{1}{4}$ NE $\frac{1}{4}$ SW $\frac{1}{4}$ of Sec. 1, Twp. 37 S., Rge. 2 W.
(Smallest legal subdivision) (N. or S.) (E. or W.)

or (b) within limits of recorded platted property, town or city:

in Lot _____, Block _____ of _____
(Name of plat or addition)

County of _____
(If within city or town, give name)

3. Construction Work was begun on March 15th, 1950; was completed on March 30th, 1950
(Date) (Date)

and the ground water claimed was first used for the purposes set out below on about June 1st, 1950
(Date)

since which time the water has been used continuously during irrigation period
(Continuously or intermittently)

from June 1st, 1950 to October 1st, 1957
(Date) (Date)

4. Quantity of water claimed and used is approximately 160 gallons per minute; 63 acre feet per year.

5. Purpose or Purposes for which water is used irrigation only

(Domestic, irrigation, municipal, manufacturing, industrial, etc.)

See Item 11 Description of Well: Depth 25 feet, Type Dug
(Dug or drilled)

diameter 16 by 28 feet. Elevation of ground at well site 1270 feet, mean sea level.
(As near as known)

Depth to water table 7 feet.

7. Capacity of Well: 160 g.p.m. with 23 feet drawdown.
_____ g.p.m. with _____ feet drawdown.

Date of test none noted from use.

If Flowing Well: Measured discharge _____ g.p.m. on _____
(Date)

Shut-in pressure at ground surface _____ lbs. per sq. in. on _____
(Date)

Water is controlled by _____
(Cap, valve, etc.)

8. Casing: (Give diameter, commercial specifications and depth below ground surface of each casing size.)

..... inch diameter none from to feet
..... inch diameter from to feet
..... inch diameter from to feet
..... inch diameter from to feet

Describe and show depth of shoe, plug, adapter, liner or other details:

9. Perforated Casings or Screens:

..... none from to
(Number per foot and size of perforations, or describe screen)
..... from to
..... from to
..... from to

10. Log of Well: (Describe each stratum or formation clearly, indicate if water bearing, and give thickness and depth as indicated.)

MATERIAL	Thickness (Feet)	Depth to Bottom (Feet)
not known		

If log of well is not available, give name and address of driller. _____ dug by owner _____

11. Infiltration Trench: Covered or open _____ open _____

Dimensions: Length 28 ft. Minimum depth 25 ft. Maximum depth 25 ft.

Bottom width 16 ft. Discharge _____ g.p.m. Date of test none

12. Tunnel: Type of lining _____

Dimensions: _____
(Length, course, and cross sectional size)

Position of water bearing stratum with reference to portal of tunnel _____

Log of tunnel: (Preceding table for log of well may be used, if desired. Give footage from portal and character of materials, as pertinent.)

13. Pumping Equipment:

(a) Pump 2 inch centrifugal pump (Fairbanks Morse) Capacity 160 g.p.m.
(Make, type and size)

(b) Motor 5.0 H.P. electric
(Type and horsepower)


14. Location of area irrigated or to be irrigated, or place of use if for purposes other than irrigation.

Township North or South	Range E. or W. of Willamette Meridian	Section	Forty-acre Tract	Number Acres To Be Irrigated	Date of Reclamation
37 S.	2 W.	1	SE 1/4 NE 1/4 SW 1/4	3.7	June 1, 1950
		1	SE 1/4 SW 1/4	10.2	June 1, 1950
			Total	13.9	

15. If the ground water supply is supplemental to an existing water supply, identification of any application for a permit, permit, certificate or adjudicated right to appropriate water made or held by the registrant.
none

Township 37 S. Range 2 W., W.M.

North Section 1

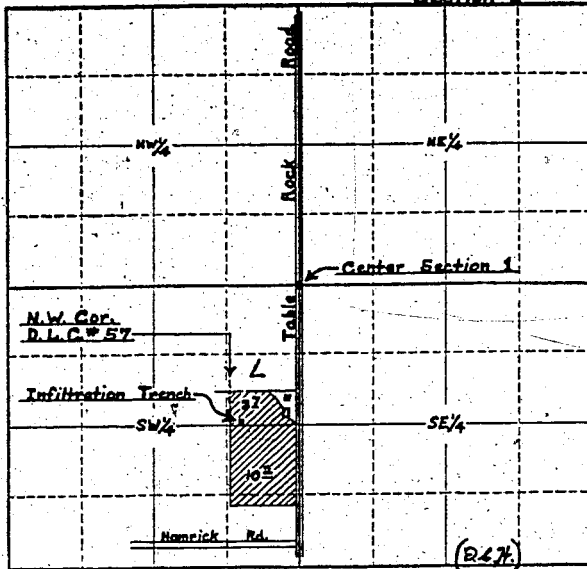

Locate well and acreage of irrigated land on plat.

Scale: $\frac{1}{4}$ " = 1 Mile

STATE OF OREGON

County of Jackson

} ss.

I, Albert H. Puhl, being first duly sworn, do hereby certify that I have read the foregoing Registration Statement and that all of the items therein contained are true to the best of my knowledge and belief.

Albert H. Puhl
(Signature of Registrant)

Subscribed and sworn to before me this 10th day of March, 1958

My commission expires August 25, 1958

[Signature]
(Notary Public)

(SEAL)

CERTIFICATE OF REGISTRATION

STATE OF OREGON

County of Marion

} ss.

This is to certify that the foregoing Registration Statement was received in the office of the State Engineer on the 9th day of May, 1958, at 5:30 o'clock A. M. and has been duly recorded in said office in Book No. 7 of Registration Statements on page GR 1501

Witness my hand this 1st day of December, 1958

[Signature]
(State Engineer)

By

(Deputy)

GR - 1501

1500