Registration No. GR - 1558

Certificate No. GR - 1502

Registration Statement

OF CLAIMANT OF RIGHT TO APPROPRIATE GROUND WATER

TO THE STATE ENGINEER OF OREGON:

I, Elmer H. Schneider,

of Route 2 Box 171 Woodburn, Oregon County of Clackamas
(Mailing address)

State of Oregon, do hereby make application for a certificate of registration as evidence of a right to appropriate ground water.

1. **Source** from which water is withdrawn is Pump well
(Flowing well, pump well, infiltration trench, or tunnel)

2. **Location** is: about four miles from Monitor going North
(Approximate distance and direction from nearest city or town)

and is more particularly described as follows:

(a) 100' S. & 100' W from center of Section 18
(Give distance and bearing to corner of section or other legal subdivision)

being within NE¼ SW¼ of Sec. 18, Twp. 5S (N. or S.), Rge. 1E (E. or W.)
(Smallest legal subdivision)

or (b) within limits of recorded platted property, town or city:

in Lot ....., Block ..... of .....
(Name of plat or addition)

..... County of Clackamas
(If within city or town, give name)

3. **Construction Work** was begun on 1942 (Date); was completed on 1942 (Date)

and the ground water claimed was first used for the purposes set out below on 1942 (Date),

since which time the water has been used Continuously (Continuously or intermittently)

from 1942 (Date) to present date (Date)

4. **Quantity** of water claimed and used is 90 gpm gallons per minute; 25 acre feet per year.

5. **Purpose or Purposes** for which water is used ~~domestic etc.~~ irrigation
(Domestic, irrigation, municipal, manufacturing, industrial, etc.)

6. **Description of Well:** Depth 72 feet. Type drilled (Dug or drilled)

diameter 8 inches. Elevation of ground at well site ..... (As near as known) feet, mean sea level.

Depth to water table ground level it overflows feet.

7. **Capacity of Well:** ..... g.p.m. with ..... feet drawdown. not been tested.

..... g.p.m. with ..... feet drawdown.

Date of test .....

If Flowing Well: Measured discharge 60 g.p.m. on 2/15/50 (Date)

Shut-in pressure at ground surface ..... lbs. per sq. in. on ..... (Date)

Water is controlled by overflow
(Cap, valve, etc.)

4M—4-57

8. **Casing:** (Give diameter, commercial specifications and depth below ground surface of each casing size.)

..... inch diameter all 8 inch from ..... to ..... feet

..... inch diameter ..... from ..... to ..... feet

..... inch diameter ..... from ..... to ..... feet

..... inch diameter ..... from ..... to ..... feet

Describe and show depth of shoe, plug, adapter, liner or other details: 72 feet

9. **Perforated Casings or Screens:**

none from ..... to .....
(Number per foot and size of perforations, or describe screen)

..... from ..... to .....

..... from ..... to .....

..... from ..... to .....

10. **Log of Well:** (Describe each stratum or formation clearly, indicate if water bearing, and give thickness and depth as indicated.)

MATERIAL	Thickness (Feet)	Depth to Bottom (Feet)
Well was drilled in 1942		
No record was kept		

GR 1502

If log of well is not available, give name and address of driller. B F Ballweber

11. **Infiltration Trench:** Covered or open .....

Dimensions: Length ..... ft. Minimum depth ..... ft. Maximum depth ..... ft.

Bottom width ..... ft. Discharge ..... g.p.m. Date of test .....

12. **Tunnel:** Type of lining .....

Dimensions: ..... (Length, course, and cross sectional size)

Position of water bearing stratum with reference to portal of tunnel .....

Log of tunnel: (Preceding table for log of well may be used, if desired. Give footage from portal and character of materials, as pertinent.)

13. **Pumping Equipment:**

(a) Pump Turbine (Peerless) (Make, type and size) Capacity 90 g.p.m.

(b) Motor 5 H. Electric (Type and horsepower)

14. Location of area irrigated or to be irrigated, or place of use if for purposes other than irrigation.

Township North or South	Range E. or W. of Willamette Meridian	Section	Forty-acre Tract	Number Acres To Be Irrigated	Date of Reclamation
5 S	1 E	18	NE¼ SW¼	29 ~~30~~ acres	1942
"	"	"	SE¼ SW¼	8	"
"	"	"	NW¼ SE¼	1	"
"	"	"	SW¼ SE¼	1	"
				Total 39	

15. If the ground water supply is supplemental to an existing water supply, identification of any application for a permit, permit, certificate or adjudicated right to appropriate water made or held by the registrant.

None

GR 1502

Township 5S Range 1E, W.M.

North

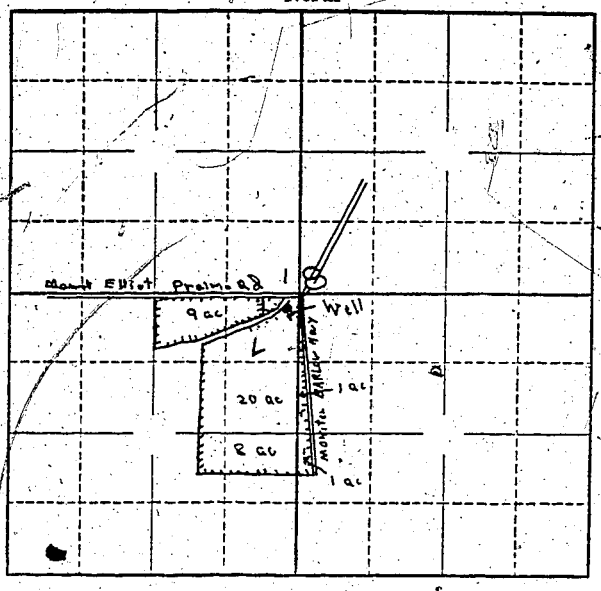

Locate well and acreage of irrigated land on plat.

Scale: 4" = 1 Mile

STATE OF OREGON
County of Marion } ss.

I, Ruth E. Schneider, being first duly sworn, do hereby certify that I have read the foregoing Registration Statement and that all of the items therein contained are true to the best of my knowledge and belief.

Ruth E. Schneider
(Signature of Registrant)

Subscribed and sworn to before me this 12th day of May, 1958

My commission expires Sept. 8, 1960

(Notary Public)

(SEAL)

CERTIFICATE OF REGISTRATION

STATE OF OREGON
County of Marion } ss.

This is to certify that the foregoing Registration Statement was received in the office of the State Engineer on the 12th day of May, 1958, at 10:15 o'clock A M. and has been duly recorded in said office in Book No. 7 of Registration Statements on page GR-1502

Witness my hand this 1st day of December, 1958.

Lewis A. Stanley
(State Engineer)

By
(Deputy)

#16.35

GR-1502