

Registration Statement

OF CLAIMANT OF RIGHT TO APPROPRIATE GROUND WATER

TO THE STATE ENGINEER OF OREGON:

I, Welp Sanden
 of Route 2 Canby, Ore. County of Clackamas
(Mailing address)
 State of Oregon, do hereby make application for a certificate of registration as evidence of a right to appropriate ground water.

1. Source from which water is withdrawn is Pump Well
(Flowing well, pump well, registration trench, or tunnel)
 2. Location is: 4 miles west of Molalla, Ore.
(Approximate distance and direction from nearest city or town)

and is more particularly described as follows:

(a) 1600' N & 750' E From S.W. cor. Sec. 11
(Give distance and bearing to corner of section or other legal subdivision)
 being within N.W. 1/4 SW 1/4 of Sec. 11, Twp. 5.5, Rge. 1.E
(Smallest legal subdivision) (N. or S.) (E. or W.)

or (b) within limits of recorded platted property, town or city:
 in Lot _____, Block _____ of _____
(Name of plat or addition)
 County of Clackamas
(If within city or town, give name)

3. Construction Work was begun on Fall of 1946, was completed on Spring 1947
(Date) (Date)
 and the ground water claimed was first used for the purposes set out below on Summer 1947
(Date)
 since which time the water has been used Continuously or Intermittently
(Continuously or Intermittently)
 from 1947 to 1957
(Date) (Date)

4. Quantity of water claimed and used is 600 gallons per minute; 175 acre
35 feet per year.

5. Purpose or Purposes for which water is used irrigation
(Domestic, irrigation, municipal, manufacturing, industrial, etc.)

6. Description of Well: Depth 465 feet, Type Drilled
(Dug or drilled)
 diameter 12" #10" inches. Elevation of ground at well site 284 feet, mean sea level.
(As near as known)
 Depth to water table 35 feet.

7. Capacity of Well: 600 g.p.m. with 130 feet drawdown.
 _____ g.p.m. with _____ feet drawdown.


Date of test Spring 1947

If Flowing Well: Measured discharge _____ g.p.m. on _____
(Date)

Shut-in pressure at ground surface _____ lbs. per sq. in. on _____
(Date)

Water is controlled by _____
(Cap, valve, etc.)

Township 5.S Range 1, E, W.M.
North

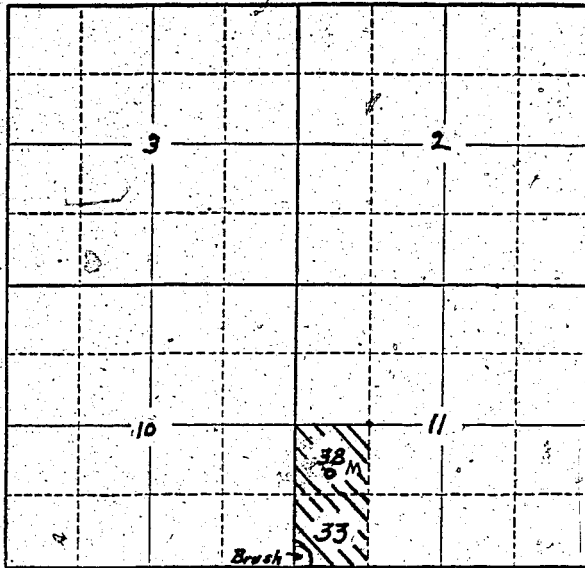

Locate well and acreage of irrigated land on plat.

Scale: 2" = 1 Mile

STATE OF OREGON

County of Marion } ss.

I, Nels Sanden, being first duly sworn, do hereby certify that I have read the foregoing Registration Statement and that all of the items therein contained are true to the best of my knowledge and belief.

Nels Sanden
(Signature of Registrant)

Subscribed and sworn to before me this 20th day of February, 1958.

My commission expires Sept. 8, 1960 Chris J. Miller
(Notary Public)

(SEAL)

CERTIFICATE OF REGISTRATION

STATE OF OREGON }
County of Marion } ss.

This is to certify that the foregoing Registration Statement was received in the office of the State Engineer on the 12th day of May, 1958, at 5:00 o'clock A.M. and has been duly recorded in said office in Book No. 7 of Registration Statements on page GR-1503

Witness my hand this 1st day of December, 1958.

\$ 21¹⁵

Lewis A. Attwood
(State Engineer)

By _____
(Deputy)