

RECEIVED
MAY 13 1958

STATE ENGINEER
SALEM, OREGON

Registration No. GR - 1562

Certificate No. GR - 1505

Registration Statement

OF CLAIMANT OF RIGHT TO APPROPRIATE GROUND WATER

TO THE STATE ENGINEER OF OREGON:

I, M. L. Gingrich
of Rt. 1, Box 283, Albany County of Linn
(Mailing address)

State of Oregon, do hereby make application for a certificate of registration as evidence of a right to appropriate ground water.

1. Source from which water is withdrawn is Pump well
(Flowing well, pump well, infiltration trench, or tunnel)

2. Location is: 8 miles SE of Albany, Oregon
(Approximate distance and direction from nearest city or town)

and is more particularly described as follows:

(a) 2838 feet south and 2112 feet east of NW corner S. 9, T. 11 S., R. 2 W.
(Give distance and bearing to corner of section or other legal subdivision)
being within NE¹ of SE¹ of Sec. 9, Twp. 11 S, Rge. 2 W
(Smallest legal subdivision) (N. or S.) (E. or W.)

or (b) within limits of recorded platted property, town or city:

in Lot _____, Block _____ of _____
(Name of plat or addition)
County of Linn
(If within city or town, give name)

3. Construction Work was begun on 1953; was completed on 1953
(Date) (Date)

and the ground water claimed was first used for the purposes set out below on June 1953
(Date)

since which time the water has been used continuously
(Continuously or intermittently)

from June 1953 to present time
(Date) (Date)

4. Quantity of water claimed and used is 102 gallons per minute; 18.75 acre feet per year.

5. Purpose or Purposes for which water is used Irrigation

(Domestic, irrigation, municipal, manufacturing, industrial, etc.)

6. Description of Well: Depth 20 feet. Type Drilled
(Dug or drilled)
diameter 10 inches. Elevation of ground at well site 270 feet, mean sea level.
(As near as known)
Depth to water table 8 feet.

7. Capacity of Well: 200 g.p.m. with 4 feet drawdown.
_____ g.p.m. with _____ feet drawdown.

Date of test June 1953

If Flowing Well: Measured discharge _____ g.p.m. on _____
(Date)

Shut-in pressure at ground surface _____ lbs. per sq. in. on _____
(Date)

Water is controlled by _____
(Cap, valve, etc.)

8. **Casing:** (Give diameter, commercial specifications and depth below ground surface of each casing size.)

10 inch diameter steel casing from 0 to 20 feet

..... inch diameter from to feet

inch diameter from to feet

_____ inch diameter _____ from _____ to _____ feet

Describe and show depth of shoe, plug, adapter, liner or other details:

9. Perforated Casings or Screens:

Slot perforations

(Number per foot and size of perforations, or describe screen)

from 14 to 20

from _____ to _____

from to


from to

10. **Log of Well:** (Describe each stratum or formation clearly, indicate if water bearing, and give thickness and depth as indicated.)

[illegible]

Albany, Oregon

Township 11 S Range 2 W W.M.
North

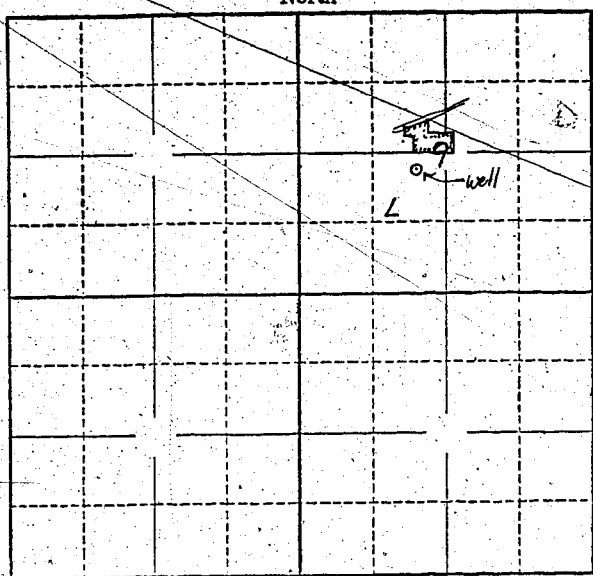

Locate well and acreage of irrigated land on plat.
Scale: 2" = 1 Mile

STATE OF OREGON }
County of LINN } ss.

I, M. L. Gingrich, being first duly sworn, do hereby certify that I have read the foregoing Registration Statement and that all of the items therein contained are true to the best of my knowledge and belief.

M. L. Gingrich
(Signature of Registrant)

Subscribed and sworn to before me this 10th day of May, 1958

My commission expires Oct. 2, 1961

Ruby Muller
(Notary Public)

(SEAL)

CERTIFICATE OF REGISTRATION

STATE OF OREGON }
County of Marion } ss.

This is to certify that the foregoing Registration Statement was received in the office of the State Engineer on the 13th day of May, 1958, at 9:00 o'clock A.M. and has been duly recorded in said office in Book No. 7 of Registration Statements on page GR-1505

Witness my hand this 1st day of December, 1958

Quora A. Atkinson
(State Engineer)

By _____
(Deputy)

\$15.00