

# Registration Statement

## OF CLAIMANT OF RIGHT TO APPROPRIATE GROUND WATER

TO THE STATE ENGINEER OF OREGON:

I, A. J. Vandecorring  
of Rt 2 Box 44 Woodburn, Oregon County of Mason  
(Mailing address)

State of Oregon, do hereby make application for a certificate of registration as evidence of a right to appropriate ground water.

- Source from which water is withdrawn is Pump Well  
(Flowing well, pump well, infiltration trench, or tunnel)
- Location is: 5 miles N.W. Mt. Angel, Oregon  
(Approximate distance and direction from nearest city or town)

and is more particularly described as follows:

(a) 1400 feet south & 900 feet west from NE corner Section 28  
(Give distance and bearing to corner of section or other legal subdivision)  
being within S.E. 1/4 of N.E. 1/4 of Sec. 28, Twp. S 5, Rge. 1 W  
(Smallest legal subdivision) (S. or S.) (E. or W.)

or (b) within limits of recorded platted property, town or city: \_\_\_\_\_

in Lot \_\_\_\_\_, Block \_\_\_\_\_ of \_\_\_\_\_  
(Name of plat or addition)  
County of \_\_\_\_\_  
(If within city or town, give name)

3. Construction Work was begun on 1948; was completed on Spring, 1949  
(Date) (Date)  
and the ground water claimed was first used for the purposes set out below on 1949  
(Date)  
since which time the water has been used continuously during season  
(Continuously or intermittently)  
from 1949 to October 1957  
(Date) (Date)

4. Quantity of water claimed and used is 210 gallons per minute; 30 acre feet per year.

5. Purpose or Purposes for which water is used Irrigation on Agriculture Farm  
(Domestic, irrigation, municipal, manufacturing, industrial, etc.)

6. Description of Well: Depth 131 feet. Type Drilled  
(Dug or drilled)  
diameter 8 inches. Elevation of ground at well site \_\_\_\_\_ feet, mean sea level.  
(As near as known)  
Depth to water table 12 feet.

7. Capacity of Well: 400 g.p.m. with 30 feet drawdown.  
600 g.p.m. with 50 feet drawdown.

Date of test May 20, 1949

If Flowing Well: Measured discharge \_\_\_\_\_ g.p.m. on \_\_\_\_\_  
(Date)


Shut-in pressure at ground surface \_\_\_\_\_ lbs. per sq. in. on \_\_\_\_\_  
(Date)

Water is controlled by \_\_\_\_\_  
(Cap, valve, etc.)

8. Casing: (Give diameter, commercial specifications and depth below ground surface of each casing size.)

8 inch diameter Steel Casing from 0 to 131 feet  
 inch diameter \_\_\_\_\_ from \_\_\_\_\_ to \_\_\_\_\_ feet  
 inch diameter \_\_\_\_\_ from \_\_\_\_\_ to \_\_\_\_\_ feet  
 inch diameter \_\_\_\_\_ from \_\_\_\_\_ to \_\_\_\_\_ feet

Describe and show depth of shoe, plug, adapter, liner or other details: \_\_\_\_\_

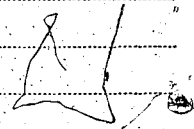

9. Perforated Casings or Screens:

Slots 15 -  $1\frac{1}{2} \times \frac{1}{4}$  from 80 to 85  
(Number per foot and size of perforations, or describe screen)  
15 Per foot  $1\frac{1}{2} \times \frac{1}{4}$  from 118 to 128  
 from \_\_\_\_\_ to \_\_\_\_\_  
 from \_\_\_\_\_ to \_\_\_\_\_

10. Log of Well: (Describe each stratum or formation clearly, indicate if water bearing, and give thickness and depth as indicated.)

MATERIAL	Thickness (Feet)	Depth to Bottom (Feet)
Clay - 80 ft. gravel & sand 5 ft.		
85 ft. to 114 ft. clay		
114 ft. to 128 ft. sand & gravel		
Sand & Gravel at each strata was water bearing		

If log of well is not available, give name and address of driller. ....

11. Infiltration Trench: Covered or open .....

Dimensions: Length ..... ft. Minimum depth ..... ft. Maximum depth ..... ft.

Bottom width ..... ft. Discharge ..... g.p.m. Date of test .....

12. Tunnel: Type of lining: 8 inch steel

Dimensions: .....  
(Length, course, and cross sectional size)

Position of water bearing stratum with reference to portal of tunnel .....

Log of tunnel: (Preceding table for log of well may be used, if desired. Give footage from portal and character of materials, as pertinent.)

13. Pumping Equipment:

(a) Pump ..... Turkines ..... Capacity 210 ..... g.p.m.  
(Make, type and size)


(b) Motor ..... H.P. 7 1/2 Electric .....  
(Type and horsepower)

14. Location of area irrigated or to be irrigated, or place of use if for purposes other than irrigation.

Township North or South	Range E. or W. of Willamette Meridian	Section	Forty-acre Tract	Number Acres To Be Irrigated	Date of Reclamation
<u>T55</u>	<u>R1W</u>	<u>28</u>	<u>NE 1/4 of NE 1/4</u>	<u>20.3</u>	<u>1949</u>
"	"	"	<u>NW 1/4 of NE 1/4</u>	<u>2.0</u>	"
"	"	"	<u>SE 1/4 of NE 1/4</u>	<u>11.0</u>	"
"	"	<u>27</u>	<u>SW 1/4 of NW 1/4</u>	<u>6.0</u>	"
				<u>39.3</u>	

15. If the ground water supply is supplemental to an existing water supply, identification of any application for a permit, permit, certificate or adjudicated right to appropriate water made or held by the registrant.

Township 55 Range 1 W, W.M.  
North

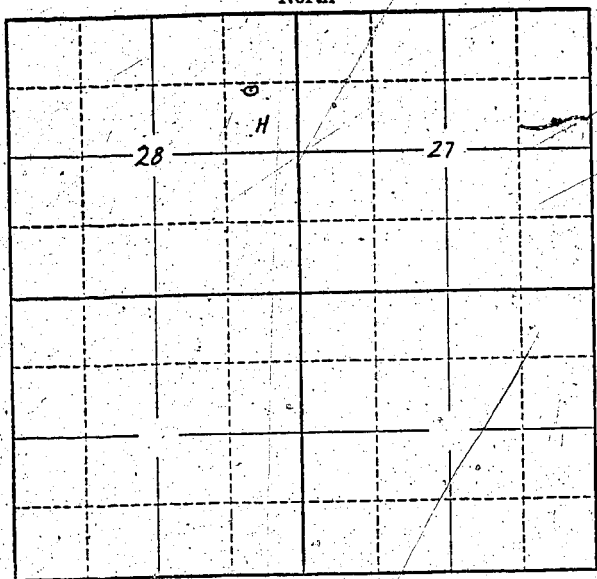

Locate well and acreage of irrigated land on plat.  
Scale: 2" = 1 Mile

STATE OF OREGON }  
County of Marion Co. } ss.

I, \_\_\_\_\_, being first duly sworn, do hereby certify that I have read the foregoing Registration Statement and that all of the items therein contained are true to the best of my knowledge and belief.

A. J. Vandervoort  
(Signature of Registrant)

Subscribed and sworn to before me this 15th day of May, 1958

My commission expires 17th June 1961 Wm. S. Bartholomew  
(Notary Public)

(SEAL)

**CERTIFICATE OF REGISTRATION**

STATE OF OREGON }  
County of Marion } ss.

This is to certify that the foregoing Registration Statement was received in the office of the State Engineer on the 15th day of May, 1958, at 3:30 o'clock P. M. and has been duly recorded in said office in Book No. 7 of Registration Statements on page GR-1511

Witness my hand this 1st day of December, 1958

Lewis A. Atkinson  
(State Engineer)

\$16.50

By \_\_\_\_\_  
(Deputy)