

Registration Statement

OF CLAIMANT OF RIGHT TO APPROPRIATE GROUND WATER

TO THE STATE ENGINEER OF OREGON:

I, John W. Eggers & Anna G. Eggers

of Rt. 1 Box 150 Brooks, Ore. County of Marion

State of Ore., do hereby make application for a certificate of registration as evidence of a right to appropriate ground water.

1. Source from which water is withdrawn is Drilled Well
(Flowing well, pump well, infiltration trench, or tunnel)

2. Location is: 4 miles N:E. of Brooks
(Approximate distance and direction from nearest city or town)

and is more particularly described as follows:

(a) 185 feet west & 90 feet north from SW corner of SE 1/4 of NW 1/4 Section 12
(Give distance and bearing to corner of section or other legal subdivision)

being within SE 1/4 - NW 1/4 of Sec. 12, Twp. 6 S., Rge. 2 W.
(Smallest legal subdivision) (N. or S.) (E. or W.)

or (b) within limits of recorded platted property, town or city: All of Lot 5
in Lot 5, Block _____ of Subdivision #3 Hayes-Labish Farms
(Name of plat or addition)

County of Marion
(If within city or town, give name)

3. Construction Work was begun on Dec. 1951; was completed on Jan. 52.
(Date) (Date)

and the ground water claimed was first used for the purposes set out below on June 1952
(Date)

since which time the water has been used Continuously
(Continuously or intermittently)

from 1952 to 1958
(Date) (Date)

4. Quantity of water claimed and used is 40 gallons per minute; _____ acre feet per year.

5. Purpose or Purposes for which water is used Irrigation

(Domestic, irrigation, municipal, manufacturing, industrial, etc.)

6. Description of Well: Depth 142 feet. Type Drilled (Cable Tools)
(Dug or drilled)

diameter 6 inches. Elevation of ground at well site 156 feet, mean sea level.
(As near as known)

Depth to water table 15 feet.

7. Capacity of Well: _____ g.p.m. with _____ feet drawdown.

Well was never tested
_____ g.p.m. with _____ feet drawdown.

Date of test _____

If Flowing Well: Measured discharge _____ g.p.m. on _____
(Date)

Shut-in pressure at ground surface _____ lbs. per sq. in. on _____
(Date)

Water is controlled by _____
(Cap, valve, etc.)

8. Casing: (Give diameter, commercial specifications and depth below ground surface of each casing size.)

6 inch diameter from Top to 142 feet
 inch diameter from to feet
 inch diameter from to feet
 inch diameter from to feet

Describe and show depth of shoe, plug, adapter, liner or other details:

Spring Steel Shoe

9. Perforated Casings or Screens:

No Perforations

(Number per foot and size of perforations, or describe screen)

from to
 from to
 from to
 from to

10. Log of Well: (Describe each stratum or formation clearly, indicate if water bearing, and give thickness and depth as indicated.)

MATERIAL	Thickness (Feet)	Depth to Bottom (Feet)
Top Soil	Top XXXX	2
Yellow silt & Clay	2	61
Yellow clay & Sand	61	74
Blue Clay	74	88
Black Sand	88	125
Blue sandy clay	125	135
Black sand & Gravel	135	142

If log of well is not available, give name and address of driller.

Wymore Well Drillers / Rt. 2 Salem, Oregon

11. Infiltration Trench: Covered or open
 Dimensions: Length ft. Minimum depth ft. Maximum depth ft.
 Bottom width ft. Discharge g.p.m. Date of test

12. Tunnel: Type of lining
 Dimensions:
 (Length, course, and cross sectional size)
 Position of water bearing stratum with reference to portal of tunnel

Log of tunnel: (Preceding table for log of well may be used, if desired. Give footage from portal and character of materials, as pertinent.)


13. Pumping Equipment:
 (a) Pump Flint & Walling (JET) Capacity 40 g.p.m.
 (Make, type and size)
 (b) Motor Electric Single phase 3 HP
 (Type and horsepower)

14. Location of area irrigated or to be irrigated, or place of use if for purposes other than irrigation.

Township North or South	Range E. or W. of Willamette Meridian	Section	Forty-acre Tract	Number Acres To Be Irrigated	Date of Reclamation
6 S	3 W	12	SE 1/4 NW 1/4	5	1952

15. If the ground water supply is supplemental to an existing water supply, identification of any application for a permit, permit, certificate or adjudicated right to appropriate water made or held by the registrant.

Township 65 Range 2W, W.M.
North

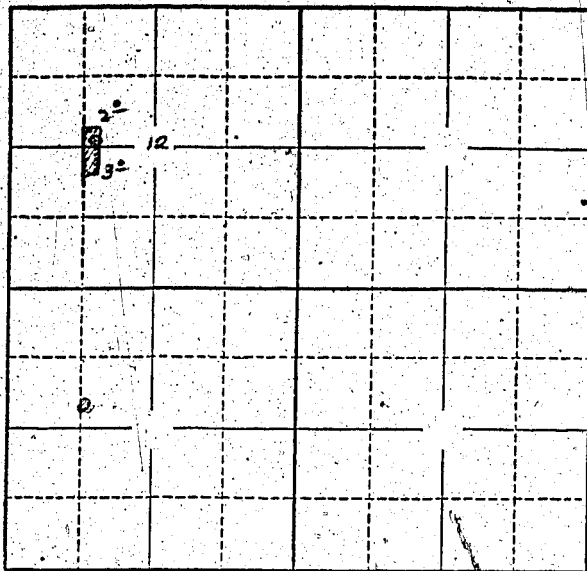

Locate well and acreage of irrigated land on plat.
Scale: 2" = 1 Mile

STATE OF OREGON

County of Marion } ss.

I, John W. Eggen, being first duly sworn, do hereby certify that I have read the foregoing Registration Statement and that all of the items therein contained are true to the best of my knowledge and belief.

John W. Eggen
(Signature of Registrant)

Subscribed and sworn to before me this 5th day of February, 1959

My commission expires Oct 29, 1962 Beverly A. Baden
(Notary Public)

(SEAL)

CERTIFICATE OF REGISTRATION

STATE OF OREGON

County of Marion } ss.

This is to certify that the foregoing Registration Statement was received in the office of the State Engineer on the 19th day of May, 1958, at 8:00 o'clock A.M. and has been duly recorded in said office in Book No. 9 of Registration Statements on page GR- [redacted] 2020

Witness my hand this 9th day of February, 1959

Lewis A. Stanley
(State Engineer)

By _____
(Deputy)

GR- [redacted] -2020

4/500
[handwritten mark]