

RECEIVED
MAY 16 1958
STATE ENGINEER
SALEM, OREGON

Registration No. GR 1575

Certificate No. GR 1517

Registration Statement

OF CLAIMANT OF RIGHT TO APPROPRIATE GROUND WATER

TO THE STATE ENGINEER OF OREGON:

I, Ammon Bros.
of Jefferson County of Marion
(Mailing address)

State of Oregon, do hereby make application for a certificate of registration as evidence of a right to appropriate ground water.

1. Source from which water is withdrawn is Pump Well No. 1
(Flowing well, pump well, infiltration trench, or tunnel)
2. Location is: 3 miles NW of Jefferson, Oregon
(Approximate distance and direction from nearest city or town)

and is more particularly described as follows:

(a) N. 18° 45' W. 43.5 chains from SE corner of SW 1/4 of S. 34, T. 9 S., R. 3 W.
(Give distance and bearing to corner of section or other legal subdivision)
being within SE 1/4 of NW 1/4 of Sec. 34, Twp. 9 S., Rge. 3 W.
(Smallest legal subdivision) (N. or S.) (E. or W.)

or (b) within limits of recorded platted property, town or city:
in Lot _____, Block _____ of _____
(Name of plat or addition)

County of Marion
(If within city or town, give name)

3. Construction Work was begun on 1950; was completed on 1950
(Date) (Date)

and the ground water claimed was first used for the purposes set out below on 1950
(Date)
since which time the water has been used continuously
(Continuously or intermittently)
from 1950 to present time
(Date) (Date)

4. Quantity of water claimed and used is 300 gallons per minute; 75.5 acre feet per year.

5. Purpose or Purposes for which water is used Irrigation

(Domestic, irrigation, municipal, manufacturing, industrial, etc.)

6. Description of Well: Depth 30 feet. Type Drilled
(Dug or drilled)

diameter 10 inches. Elevation of ground at well site 200 feet, mean sea level
(As near as known)

Depth to water table 10 feet.

7. Capacity of Well: 400 g.p.m. with 7 feet drawdown.

_____ g.p.m. with _____ feet drawdown.


Date of test Estimated

If Flowing Well: Measured discharge _____ g.p.m. on _____
(Date)

Shut-in pressure at ground surface _____ lbs. per sq. in. on _____
(Date)

Water is controlled by _____
(Cap, valve, etc.)

Township 9 S Range 3 W W.M.
North

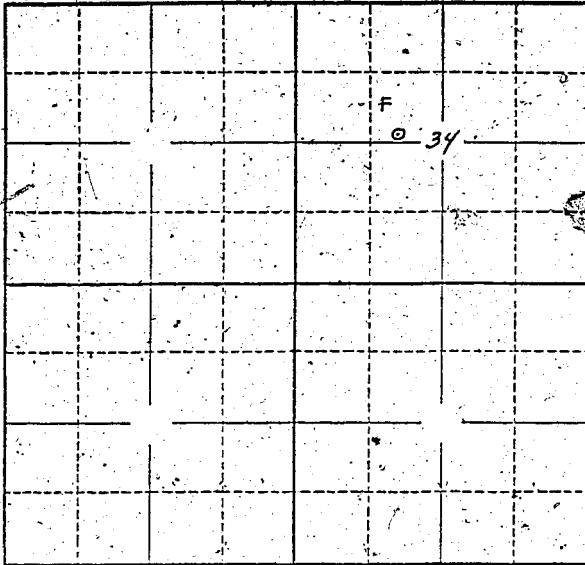

Locate well and acreage of irrigated land on plat.

Scale: 2" = 1 Mile

STATE OF OREGON

County of LINN

} ss.

I, Ammon Bros., being first duly sworn, do hereby certify that I have read the foregoing Registration Statement and that all of the items therein contained are true to the best of my knowledge and belief.

Ammon Bros
Ed. E. Ammon
(Signature of Registrant)

Subscribed and sworn to before me this 13th day of May, 1958

MY COMMISSION EXPIRES FEB. 12, 1966

My commission expires

Jeff Chaushe
(Notary Public)

(SEAL)

CERTIFICATE OF REGISTRATION

STATE OF OREGON

County of Marion

} ss.

This is to certify that the foregoing Registration Statement was received in the office of the State Engineer on the 19th day of May, 1958, at 8:00 o'clock A. M. and has been duly recorded in said office in Book No. 7 of Registration Statements on page GR-1517

Witness my hand this 1st day of December, 1958

Laura A. Ostrander
(State Engineer)

By

(Deputy)

GR-1517

#1515