

RECEIVED
MAY 19 1958
STATE ENGINEER
SALEM, OREGON

Registration No. GR - 1582
Certificate No. GR - 1529

Registration Statement

OF CLAIMANT OF RIGHT TO APPROPRIATE GROUND WATER

TO THE STATE ENGINEER OF OREGON:

I, A Burr Black
Class Pearl Black

of 2270 Chemawa Road Salem County of Marion
(Mailing address)

State of Oregon, do hereby make application for a certificate of registration as evidence of a right to appropriate ground water.

1. Source from which water is withdrawn is pump well
(Flowing well, pump well, infiltration trench, or tunnel)
2. Location is: 6 miles N. of Salem (by road)
(Approximate distance and direction from nearest city or town)

and is more particularly described as follows:

(a) 201' S. and 114' E. of the NE corner W.P.P. 34 R. 16 #41
(Give distance and bearing to corner of section or other legal subdivision)
being within NW 1/4 S1N 14 of Sec. 36, Twp. 6 S, Rge. 3 W
(Smallest legal subdivision) (N. or S.) (E. or W.)

or (b) within limits of recorded platted property, town or city:

in Lot _____, Block _____ of _____
(Name of plat or addition)
County of Marion
(If within city or town, give name)

3. Construction Work was begun on 1944; was completed on before 1945
(Date) (Date)
and the ground water claimed was first used for the purposes set out below on 1953
(Date)
since which time the water has been used intermittent each season May to October
(Continuously or intermittently)
from 1953 to 1959
(Date) (Date)

4. Quantity of water claimed and used is 30 gpm gallons per minute; 8 acre feet per year.

5. Purpose or Purposes for which water is used irrigation

(Domestic, irrigation, municipal, manufacturing, industrial, etc.)

6. Description of Well: Depth 50 feet, Type drilled
(Dug or drilled)
diameter 5 inches. Elevation of ground at well site 170 feet, mean sea level.
(As near as known)
Depth to water table 18 feet.

7. Capacity of Well: Unknown g.p.m. with _____ feet drawdown.
_____ g.p.m. with _____ feet drawdown.


Date of test _____

If Flowing Well: Measured discharge _____ g.p.m. on _____
(Date)

Shut-in pressure at ground surface _____ lbs. per sq. in. on _____
(Date)

Water is controlled by _____
(Cap, valve, etc.)

Township 6S Range 3W W.M.
North

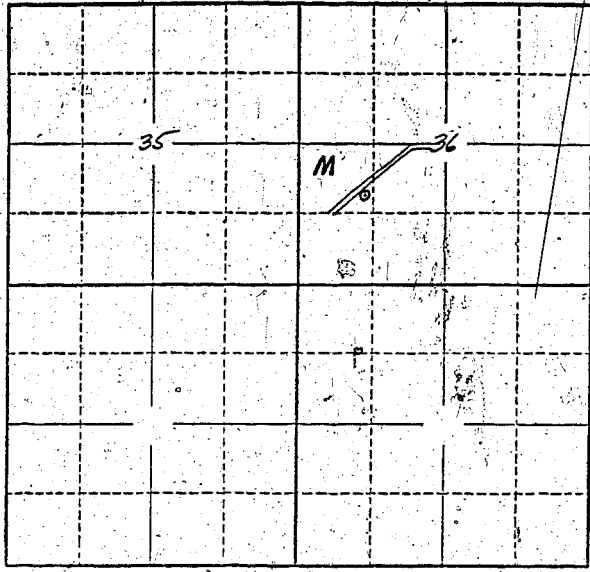

Locate well and acreage of irrigated land on plat.
Scale: 2" = 1 Mile

STATE OF OREGON

County of Marion ss.

I, A. Burr Black & Edna Pearl Black, being first duly sworn, do hereby certify that I have read the foregoing Registration Statement and that all of the items therein contained are true to the best of my knowledge and belief.

A. Burr Black
Edna Pearl Black
(Signature of Registrant)

Subscribed and sworn to before me this 20th day of February, 1958.

My commission expires Sept. 8, 1960 Chas. T. [Signature]
(Notary Public)

(SEAL)

CERTIFICATE OF REGISTRATION

STATE OF OREGON }
County of Marion } ss.

This is to certify that the foregoing Registration Statement was received in the office of the State Engineer on the 19th day of May, 1958, at 8.00 o'clock A.M. and has been duly recorded in said office in Book No. 7 of Registration Statements on page GR-1529

Witness my hand this 1st day of December, 1958

Lewis A. Stanley
(State Engineer)

By _____ (Deputy)

\$15.00