

RECEIVED
MAY 18 1958
STATE ENGINEER
SALEM, OREGON

Registration No. GR 1583
Certificate No. GR 1531

Registration Statement

OF CLAIMANT OF RIGHT TO APPROPRIATE GROUND WATER

TO THE STATE ENGINEER OF OREGON:

I, CLIFFORD R. BOWSER

of Rt 2 Box 381 Eugene County of LANE

State of ORGE, do hereby make application for a certificate of registration as evidence of a right to appropriate ground water.

1. Source from which water is withdrawn is Pump # 1
(Flowing well, pump well, infiltration trench, or funnel)

2. Location is: 1 1/2 SW of Coburg
(Approximate distance and direction from nearest city or town)

and is more particularly described as follows:

(a) S. 490'; E. 250' from the NW corner of the SW 1/4 Sec 32
(Give distance and bearing to corner of section or other legal subdivision)

being within NW 1/4 SW 1/4 of Sec. 32, Twp. 16 S., Rge. 3 W.
(Smallest legal subdivision) (N. or S.) (E. or W.)

or (b) within limits of recorded platted property, town or city:

in Lot _____, Block _____ of _____
(Name of plat or addition)

(If within city or town, give name) County of LANE

3. Construction Work was begun on 1933; was completed on 1933
(Date) (Date)

and the ground water claimed was first used for the purposes set out below on 1933
(Date)

since which time the water has been used INTER
(Continuously or intermittently)

from MAY to Oct
(Date) (Date)

4. Quantity of water claimed and used is 150 gallons per minute; 25 acre feet per year.

5. Purpose or Purposes for which water is used IRRIG ~~DRIVE~~

(Domestic, irrigation, municipal, manufacturing, industrial, etc.)

6. Description of Well: Depth 18 feet. Type DRIVE
(Dug or drilled)

diameter (4) 1/4 inches. Elevation of ground at well site 375 feet, mean sea level.
(As near as known)

Depth to water table 12 feet.

7. Capacity of Well: _____ g.p.m. with _____ feet drawdown.

_____ g.p.m. with _____ feet drawdown.

Date of test N.O. TEST MADE


If Flowing Well: Measured discharge _____ g.p.m. on _____
(Date)

Shut-in pressure at ground surface _____ lbs. per sq. in. on _____
(Date)

Water is controlled by _____
(Cap, valve, etc.)

See attached map

Township 16S Range 3W, W.M.
North

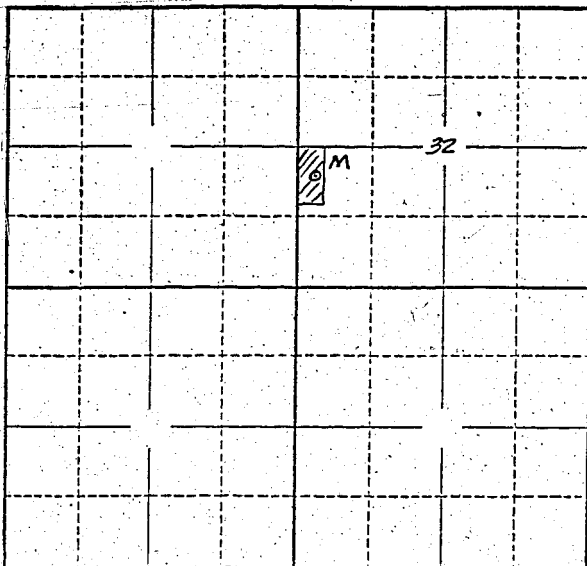

Locate well and acreage of irrigated land on plat.
Scale: 2" = 1 Mile

STATE OF OREGON

County of Lane } ss.

I, Clifford R. Bowser, being first duly sworn, do hereby certify that I have read the foregoing Registration Statement and that all of the items therein contained are true to the best of my knowledge and belief.

Clifford R. Bowser
(Signature of Registrant)

Subscribed and sworn to before me this 14 day of May, 1958.

My commission expires March 4, 1954
(Notary Public)

(SEAL)

CERTIFICATE OF REGISTRATION

STATE OF OREGON } ss.
County of Marion

This is to certify that the foregoing Registration Statement was received in the office of the State Engineer on the 14th day of May, 1958, at 8:00 o'clock A. M. and has been duly recorded in said office in Book No. 7 of Registration Statements on page GR-1531

Witness my hand this 1st day of December, 1958

Levors A. Stanley
(State Engineer)

By _____
(Deputy)

\$15.00

GR - 1531