

RECEIVED
MAY 20 1958
STATE ENGINEER
SALEM, OREGON

Registration No. GR - 1587

Certificate No. GR - 1535

Registration Statement

OF CLAIMANT OF RIGHT TO APPROPRIATE GROUND WATER

TO THE STATE ENGINEER OF OREGON:

I, WAYNE ENDICOTT
of Box 2200, R2A, Springfield, Ore County of Wheeler
State of Oregon do hereby make application for a certificate of registration as evidence of a right to appropriate ground water:

1. Source from which water is withdrawn is pump well
(Flowing well, pump well, infiltration trench, or tunnel)

2. Location is: 1 1/2 miles east Springfield, Ore
(Approximate distance and direction from nearest city or town)

and is more particularly described as follows:

(a) 1025' x 500' from Quarter Section
(Give distance and bearing to corner of section or other legal subdivision)
being within SE 1/4 of N 1/4 of Sec. 29, Twp. 17N, Rge. 11W
(Smallest legal subdivision) (N. or S.) (E. or W.)

or (b) within limits of recorded platted property, town or city: N/A
in Lot _____, Block _____ of _____
(Name of plat or addition)
County of _____
(If within city or town, give name)

3. Construction Work was begun on March 10, 1958; was completed on March 10, 1958
(Date) (Date)

and the ground water claimed was first used for the purposes set out below on March 10, 1958
(Date)
since which time the water has been used Continuously
(Continuously or Intermittently)
from March 10, 1958 to ground date
(Date) (Date)

4. Quantity of water claimed and used is 300 gallons per minute; 2.2 acre feet per year.

5. Purpose or Purposes for which water is used Irrigation
(Domestic, irrigation, municipal, manufacturing, industrial, etc.)

6. Description of Well: Depth 110 feet. Type Dug
(Dug or drilled)
diameter 49 inches. Elevation of ground at well site 800 feet, mean sea level.
(As near as known)
Depth to water table 13 feet.

7. Capacity of Well: 700 g.p.m. with 5 feet drawdown.
_____ g.p.m. with _____ feet drawdown.

Date of test 30 Aug 58

If Flowing Well: Measured discharge N/A g.p.m. on _____
(Date)

Shut-in pressure at ground surface _____ lbs. per sq. in. on _____
(Date)

Water is controlled by _____
(Cap, valve, etc.)

8. Casing: (Give diameter, commercial specifications and depth below ground surface of each casing size.)

4 N/A inch diameter from to feet
 inch diameter from to feet
 inch diameter from to feet
 inch diameter from to feet

Describe and show depth of shoe, plug, adapter, liner or other details:

9. Perforated Casings or Screens:

N/A from to
 (Number per foot and size of perforations, or describe screen)
 from to
 from to
 from to

10. Log of Well: (Describe each stratum or formation clearly, indicate if water bearing, and give thickness and depth as indicated.)

MATERIAL	Thickness (Feet)	Depth to Bottom (Feet)
Water bearing soil not water bearing	11	11
Travel water bearing	11	

If log of well is not available, give name and address of driller. 15/A

11. Infiltration Trench: Covered or open 15/A

Dimensions: Length _____ ft. Minimum depth _____ ft. Maximum depth _____ ft.

Bottom width _____ ft. Discharge _____ g.p.m. Date of test _____

12. Tunnel: Type of lining 15/B

Dimensions: _____
(Length, course, and cross sectional size)

Position of water bearing stratum with reference to portal of tunnel _____

Log of tunnel: (Preceding table for log of well may be used, if desired. Give footage from portal and character of materials, as pertinent.)

13. Pumping Equipment:

(a) Pump Fairbanks-Morse Centrifugal 2 1/2 Capacity 3000 g.p.m.
(Make, type and size)


(b) Motor Electric 1 1/4 H.P.
(Type and horsepower)

14. Location of area irrigated or to be irrigated, or place of use if for purposes other than irrigation.

Township North or South	Range E. or W. of Willamette Meridian	Section	Forty-acre Tract	Number Acres To Be Irrigated	Date of Reclamation
173	1W	29	SE 1/4 1114	25	15-12-40
173	1W	29	NE 1/4 1114	25	15-12-40
				<u>29.25</u>	

15. If the ground water supply is supplemental to an existing water supply, identification of any application for a permit, permit, certificate or adjudicated right to appropriate water made or held by the registrant.

Township 17S Range 1W, W.M.
North

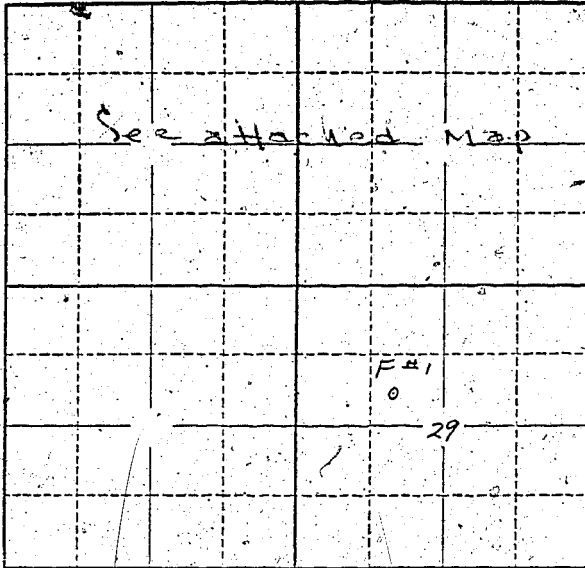

Locate well and acreage of irrigated land on plat.

Scale: 2" = 1 Mile

STATE OF OREGON

County of Marion } ss.

I, Wayne E. Dickert, being first duly sworn, do hereby certify that I have read the foregoing Registration Statement and that all of the items therein contained are true to the best of my knowledge and belief.

Wayne E. Dickert
(Signature of Registrant)

Subscribed and sworn to before me this 15 day of May, 1958

My commission expires Hermon Anderson
(Notary Public)

(SEAL)

CERTIFICATE OF REGISTRATION

STATE OF OREGON } ss.
County of Marion

This is to certify that the foregoing Registration Statement was received in the office of the State Engineer on the 20th day of May, 1958, at 6:00 o'clock A. M. and has been duly recorded in said office in Book No. 7 of Registration Statements on page GR-1535

Witness my hand this 1st day of December, 1958

Lewis A. Stanley
(State Engineer)

By _____
(Deputy)

#15.00