

RECEIVED
MAY 21 1953
STATE ENGINEER
SALEM, OREGON

Registration No. GR. - 1590

Certificate No. GR. - 1538

Registration Statement

OF CLAIMANT OF RIGHT TO APPROPRIATE GROUND WATER

TO THE STATE ENGINEER OF OREGON:

I, REESE WINGARD

of 2510 Charnelton Street, Eugene, Oregon County of Lane
(Mailing address)

State of Oregon, do hereby make application for a certificate of registration as evidence of a right to appropriate ground water.

1. Source from which water is withdrawn is 4" driven well
(Flowing well, pump well, infiltration trench, or tunnel)
2. Location is: 1.5 miles South of Springfield, Oregon
(Approximate distance and direction from nearest city or town)

and is more particularly described as follows:

(a) 1440' North and 1636.4' East of West 1/4 corner Section 12, T18S R3W
(Give distance and bearing to corner of section or other legal subdivision)
being within N.E. 1/4 N.W. 1/4 of Sec. 12, Twp. 18 South, Rge. 3 West
(Smallest legal subdivision) (N. or S.) (E. or W.)

or (b) within limits of recorded platted property, town or city:

in Lot _____, Block _____ of _____
(Name of plat or addition)
County of _____
(If within city or town, give name)

3. Construction Work was begun on May 1953; was completed on May 1953
(Date) (Date)
and the ground water claimed was first used for the purposes set out below on May 1953
(Date)
since which time the water has been used continuously
(Continuously or intermittently)
from May 1953 to May 1958
(Date) (Date)

4. Quantity of water claimed and used is 300 gallons per minute; 180 acre feet per year.

5. Purpose or Purposes for which water is used irrigation of mint and row crops

(Domestic, irrigation, municipal, manufacturing, industrial, etc.)

6. Description of Well: Depth 17 feet. Type driven
(Dug or drilled)
diameter 4 inches. Elevation of ground at well site 470 feet, mean sea level.
(As near as known)
Depth to water table 8 feet.

7. Capacity of Well: 300 g.p.m. with 2 feet drawdown.
_____ g.p.m. with _____ feet drawdown.

Date of test _____

If Flowing Well: Measured discharge _____ g.p.m. on _____
(Date)

Shut-in pressure at ground surface _____ lbs. per sq. in. on _____
(Date)

Water is controlled by _____
(Cap, valve, etc.)

8. Casing: (Give diameter, commercial specifications and depth below ground surface of each casing size.)

4 inch diameter from 0 to 17 feet
 inch diameter from to feet
 inch diameter from to feet
 inch diameter from to feet

Describe and show depth of shoe, plug, adapter, liner or other details: slotted well point

9. Perforated Casings or Screens:

(Number per foot and size of perforations, or describe screen) from to
 from to
 from to
 from to

10. Log of Well: (Describe each stratum or formation clearly, indicate if water bearing, and give thickness and depth as indicated.)

MATERIAL	Thickness (Feet)	Depth to Bottom (Feet)
Soil, River loam	6	6
Gravel	11	17

If log of well is not available, give name and address of driller.

11. Infiltration Trench: Covered or open

Dimensions: Length ft. Minimum depth ft. Maximum depth ft.

Bottom width ft. Discharge g.p.m. Date of test

12. Tunnel: Type of lining

Dimensions:
(Length, course, and cross sectional size)

Position of water bearing stratum with reference to portal of tunnel

Log of tunnel: (Preceding table for log of well may be used, if desired. Give footage from portal and character of materials, as pertinent.)

13. Pumping Equipment:

(a) Pump Pacific centrifugal Capacity 300 g.p.m.
(Make, type and size)


(b) Motor 15 General Electric Motor
(Type and horsepower)

14. Location of area irrigated or to be irrigated, or place of use if for purposes other than irrigation.

Township North or South	Range E. or W. of Willamette Meridian	Section	Forty-acre Tract	Number Acres To Be Irrigated	Date of Reclamation
18 S	R 3 W	11	NE $\frac{1}{4}$, NE $\frac{1}{4}$	2.8	May 1953
18 S	R 3 W	11	SE $\frac{1}{4}$, NE $\frac{1}{4}$	2.2	" "
18 S	R 3 W	12	NW $\frac{1}{4}$, NW $\frac{1}{4}$	26.4	" "
18 S	R 3 W	12	SW $\frac{1}{4}$, NW $\frac{1}{4}$	20.5	" "
18 S	R 3 W	12	NE $\frac{1}{4}$, NW $\frac{1}{4}$	27.9	" "
18 S	R 3 W	12	SE $\frac{1}{4}$, NW $\frac{1}{4}$	37.0	" "
18 S	R 3 W	12	NE $\frac{1}{4}$, SW $\frac{1}{4}$	3.2	" "
				120.0	" "

15. If the ground water supply is supplemental to an existing water supply, identification of any application for a permit, permit, certificate or adjudicated right to appropriate water made or held by the registrant.

Township 18 South, Range 3 West, W.M.
North

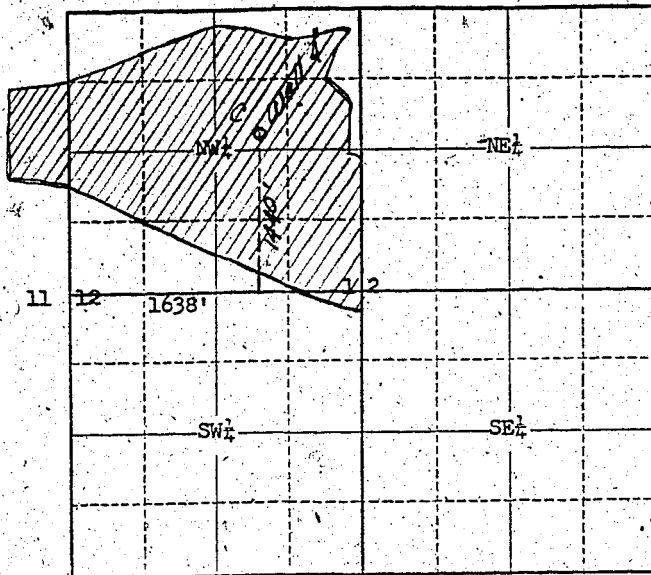

Locate well and acreage of irrigated land on plat.

Scale: $\frac{3}{4}$ " = 1 Mile
 $\frac{1}{4}$ " = 1 mile

STATE OF OREGON

County of Linn } ss.

I, Reese Wingard, being first duly sworn, do hereby certify that I have read the foregoing Registration Statement and that all of the items therein contained are true to the best of my knowledge and belief.

Reese Wingard
(Signature of Registrant)

Subscribed and sworn to before me this 15th day of May, 1956.

My commission expires MY COMMISSION EXPIRES MAY 30, 1961

Charles D. [Signature]
(Notary Public)

(SEAL)

CERTIFICATE OF REGISTRATION

STATE OF OREGON

County of Marion } ss.

This is to certify that the foregoing Registration Statement was received in the office of the State Engineer on the 21st day of May, 1956, at 8:00 o'clock A. M. and has been duly recorded in said office in Book No. 7 of Registration Statements on page GR-1538

Witness my hand this 1st day of December, 1958.

Lewis A. Stanley
(State Engineer)

\$ 26.50

By _____ (Deputy)

GR - 1538