

Registration Statement

OF CLAIMANT OF RIGHT TO APPROPRIATE GROUND WATER

TO THE STATE ENGINEER OF OREGON:

I, Donald Davidson

of Star Route, Box 22, St. Paul County of Marion

(Mailing address)

State of Oregon, do hereby make application for a certificate of registration as evidence of a right to appropriate ground water.

1. Source from which water is withdrawn is pump well

(Flowing well, pump well, infiltration trench, or tunnel)

2. Location is: 1 mile South & 1/2 mile East of St. Paul

(Approximate distance and direction from nearest city or town)

and is more particularly described as follows:

(a) 280' North & 400' West of N.E. corner of Ceril Bertrand D.L.C. #89

(Give distance and bearing to corner of section or other legal subdivision)

being within NE 1/4 of SE 1/4 of Sec. 30, Twp. 4 S, Rge. 2 W

(Smallest legal subdivision)

(N. or S.)

(E. or W.)

or (b) within limits of recorded platted property, town or city:

in Lot _____, Block _____ of _____

(Name of plat or addition)

County of _____

(If within city or town, give name)

3. Construction Work was begun on April 1950; was completed on May 1950

(Date)

(Date)

and the ground water claimed was first used for the purposes set out below on June 2, 1950

(Date)

since which time the water has been used continuously

(Continuously or intermittently)

from May 1950 to April 1958

(Date)

(Date)

4. Quantity of water claimed and used is 340 gallons per minute; _____ acre feet per year.

5. Purpose or Purposes for which water is used irrigation

(Domestic, irrigation, municipal, manufacturing, industrial, etc.)

6. Description of Well: Depth 222 feet. Type drilled

(Dug or drilled)

diameter 10 inches. Elevation of ground at well site 170 feet, mean sea level.

(As near as known)

Depth to water table 19 feet.

7. Capacity of Well:	<u>200</u>	g.p.m. with	<u>126</u>	feet drawdown.
	<u>225</u>		<u>140</u>	
	<u>300</u>	g.p.m. with	<u>160</u>	feet drawdown.
	<u>320</u>		<u>180</u>	
	<u>500</u>		<u>204-222</u>	

Date of test May 1950

If Flowing Well: Measured discharge _____ g.p.m. on _____

(Date)


Shut-in pressure at ground surface _____ lbs. per sq. in. on _____

(Date)

Water is controlled by _____

(Cap, valve, etc.)

Township 45 Range 24 W.M.
North

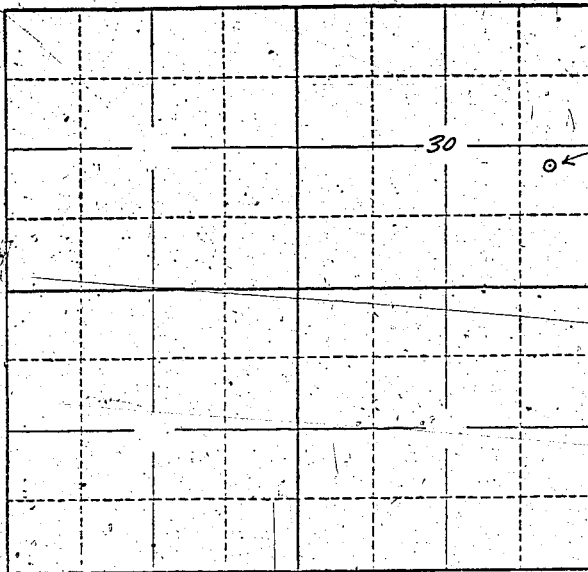

Locate well and acreage of irrigated land on plat.
Scale: 2" = 1 Mile

STATE OF OREGON


I, Donald Dawson, being first duly sworn, do hereby certify that I have read the foregoing Registration Statement and that all of the items therein contained are true to the best of my knowledge and belief.

Donald Dawson
(Signature of Registrant)

Subscribed and sworn to before me this 20th day of May, 1958

My commission expires July 29, 1960 [Signature]
(Notary Public)

(SEAL)

CERTIFICATE OF REGISTRATION

STATE OF OREGON

County of Marion } ss.

This is to certify that the foregoing Registration Statement was received in the office of the State Engineer on the 22nd day of May, 1958, at 8:00 o'clock A. M. and has been duly recorded in said office in Book No. 7 of Registration Statements on page GR-1510

Witness my hand this 1st day of December, 1958

Lewis A. Stanley
(State Engineer)

By _____ (Deputy)

GR - 1510

26-45