

Registration No. GR - 1594

Certificate No. GR - 1512

MAY 21 1958
STATE ENGINEER
OREGON

Registration Statement

OF CLAIMANT OF RIGHT TO APPROPRIATE GROUND WATER

TO THE STATE ENGINEER OF OREGON:

HAYDEN ISLAND AMUSEMENT COMPANY,
I, ~~HAYDEN ISLAND AMUSEMENT CO.~~, an Oregon corporation

of Highway 99 at Interstate Bridge, Portland 17 County of Multnomah
(Mailing address)

State of Oregon, do hereby make application for a certificate of registration as evidence of a right to appropriate ground water.

1. Source from which water is withdrawn is PUMP WELL
(Flowing well, pump well, infiltration trench, or tunnel)

2. Location is: Hayden Island, approximately 2 Miles North from Portland, Oregon;
(Approximate distance and direction from nearest city or town)

and is more particularly described as follows:

(a) 1348 ft. N 12° 30' E from the SW corner of Section 34
(Give distance and bearing to corner of section or other legal subdivision)

being within SW 1/4 of SW 1/4 of Sec. 34, Twp. 2 N, Rge. 1 E
(Smallest legal subdivision) (N. or S.) (E. or W.)

or (b) within limits of recorded platted property, town or city:

in Lot _____, Block _____ of _____
(Name of plat or addition)

County of _____
(If within city or town, give name)

3. Construction Work was begun on unavailable; was completed on December 26, 1943
(Date) (Date)

and the ground water claimed was first used for the purposes set out below on January 2, 1944
(Date)

since which time the water has been used continuously
(Continuously or intermittently)

from January 2, 1944 to present
(Date) (Date)

4. Quantity of water claimed and used is 1000 gallons per minute; _____ acre feet per year.

5. Purpose or Purposes for which water is used, Industrial and Domestic
(Domestic, irrigation, municipal, manufacturing, industrial, etc.)

6. Description of Well: Depth 232 feet. Type Drilled
(Dug or drilled)

diameter 12 inches. Elevation of ground at well site 28 feet, mean sea level.
(As near as known)

Depth to water table 27 feet.

7. Capacity of Well: 1000 g.p.m. with 34 feet drawdown.

800 g.p.m. with 27 feet drawdown.

Date of test December 26, 1943

If Flowing Well: Measured discharge _____ g.p.m. on _____
(Date)

Shut-in pressure at ground surface _____ lbs. per sq. in. on _____
(Date)

Water is controlled by _____
(Cap, valve, etc.)

8. Casing: (Give diameter, commercial specifications and depth below ground surface of each casing size.)

12 inch diameter from surface to 190 feet
10 inch diameter from 181 to 232 feet
..... inch diameter from to feet
..... inch diameter from to feet

Describe and show depth of shoe, plug, adapter, liner or other details: Overlap of 10" pipe in 12" casing 9 ft.

9. Perforated Casings or Screens:

Number and size of screen not available from 200' to 210' 6"
(Number per foot and size of perforations, or describe screen)
Number and size of screen not available from 212' to 220'
..... from to
..... from to

10. Log of Well: (Describe each stratum or formation clearly, indicate if water bearing, and give thickness and depth as indicated.)

MATERIAL	Thickness (Feet)	Depth to Bottom (Feet)
Dredge sand and silt with fine sand	166	166
Sand gravel with some water	12	178
Cemented gravel	17	195
Water bearing gravel	25	220
Gravel with clay binder	12	232

If log of well is not available, give name and address of driller. R. J. Strasser Drilling Co.

8110 S. E. Sunset Lane, Portland 6, Oregon

11. Infiltration Trench: Covered or open None
 Dimensions: Length _____ ft. Minimum depth _____ ft. Maximum depth _____ ft.
 Bottom width _____ ft. Discharge _____ g.p.m. Date of test _____

12. Tunnel: Type of lining None
 Dimensions: _____
 (Length, course, and cross sectional size)
 Position of water bearing stratum with reference to portal of tunnel _____

Log of tunnel: (Preceding table for log of well may be used, if desired. Give footage from portal and character of materials, as pertinent.)

13. Pumping Equipment:


H-4-L Uni. surface discharge head 80' of 8" x 1 3/8" discharge column
 5 stage 12" MC Turbine
 60 HP 1760 RPM 1000 GPM. 215' Total Head Westinghouse motor

Township North or South	Range E. or W. of Willamette Meridian	Section	Forty-acre Tract	Number Acres To Be Irrigated	Date of Reclamation
2 N	1 E	34	SW 1/4 of SW 1/4	Industrial	JAN. 1944
2 N	1 E	34	NW 1/4 of SW 1/4	Industrial & Dom.	" "
2 N	1 E	34	NE 1/4 of SW 1/4	Industrial & Dom.	" "
2 N	1 E	34	SW 1/4 of NW 1/4	Industrial	" "
2 N	1 E	34	SW 1/4 of NW 1/4	Industrial	" "
2 N	1 E	34	SE 1/4 of NW 1/4	Industrial	" "
2 N	1 E	33	NE 1/4 of SE 1/4	Industrial	" "
2 N	1 E	33	SE 1/4 of NE 1/4	Industrial	" "

15. If the ground water supply is supplemental to an existing water supply, identification of any application for a permit, permit, certificate or adjudicated right to appropriate water made or held by the registrant.

None

Township 2 N Range 1 E, W.M.
North

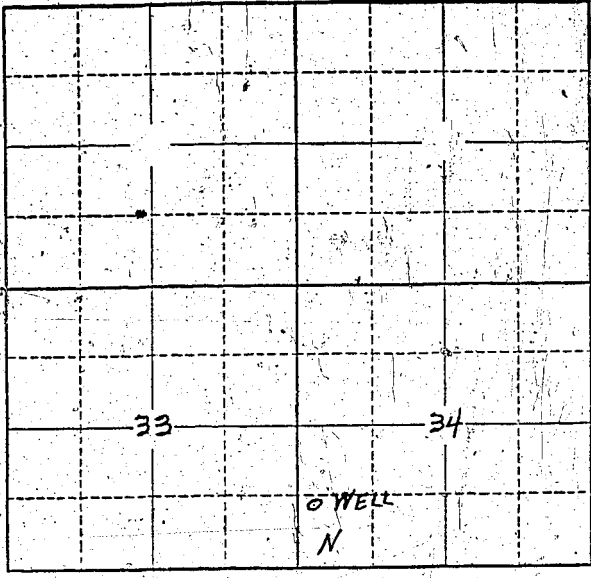

Locate well and acreage of irrigated land on plat.
Scale: 2" = 1 Mile

STATE OF OREGON
County of MULTNOMAH } ss.

I, RUTH TURPIN, SECRETARY OF REGISTRANT, being first duly sworn, do hereby certify that I have read the foregoing Registration Statement and that all of the items therein contained are true to the best of my knowledge and belief, and make this verification for and on behalf of said Registrant.

Ruth Turpin
(Signature of Registrant)

Subscribed and sworn to before me this 25th day of June, 1958.

My commission expires June 30, 1959 *[Signature]*
(Notary Public)

(SEAL)

CERTIFICATE OF REGISTRATION

STATE OF OREGON } ss.
County of Marion

This is to certify that the foregoing Registration Statement was received in the office of the State Engineer on the 22nd day of May, 1958, at 6:00 o'clock A. M. and has been duly recorded in said office in Book No. 7 of Registration Statements on page GR-1512

Witness my hand this 1st day of December, 1958

Lewis A. [Signature]
(State Engineer)

By _____
(Deputy)

24.00

GR - 1512