

Registration No. GR - 1595

Certificate No. GR - 1543

MAY 27 1958
STATE ENGINEER
SALES & SERVICE

Registration Statement

OF CLAIMANT OF RIGHT TO APPROPRIATE GROUND WATER

TO THE STATE ENGINEER OF OREGON:

I, Fred V. Kropf
of Rt. 1, Box 330, Albany County of Linn
(Mailing address)

State of Oregon, do hereby make application for a certificate of registration as evidence of a right to appropriate ground water.

1. Source from which water is withdrawn is Pump Well
(Flowing well, pump well, infiltration trench, or tunnel)

2. Location is: 8 miles SE of Albany, Oregon
(Approximate distance and direction from nearest city or town)

and is more particularly described as follows:

(a) N. 85° W. 9.5 chains from SE corner of S. 17, T. 11 S., R. 2 W.F.M.
(Give distance and bearing to corner of section or other legal subdivision)

being within SE $\frac{1}{2}$ of SE $\frac{1}{4}$ of Sec. 17, Twp. 11 S., Rge. 2 W.
(Smallest legal subdivision) (N. or S.) (E. or W.)

or (b) within limits of recorded platted property, town or city:

in Lot _____, Block _____ of _____
(Name of plat or addition)

County of Linn
(If within city or town, give name)

3. Construction Work was begun on April 1951; was completed on April 20, 1951
(Date) (Date)

and the ground water claimed was first used for the purposes set out below on June 1951
(Date)

since which time the water has been used continuously
(Continuously or intermittently)

from June 1951 to end of 1955 season - will use again when irrigated crop grown
(Date) (Date)

4. Quantity of water claimed and used is 110 gallons per minute; 13.5 acre feet per year.

5. Purpose or Purposes for which water is used Irrigation
(Domestic, irrigation, municipal, manufacturing, industrial, etc.)

6. Description of Well: Depth 97 feet. Type Drilled
(Dug or drilled)

diameter 8 inches. Elevation of ground at well site 280 feet, mean sea level.
(As near as known)

Depth to water table 8 feet.

7. Capacity of Well: 110 g.p.m. with 45 feet drawdown.

_____ g.p.m. with _____ feet drawdown.


Date of test August 1951

If Flowing Well: Measured discharge _____ g.p.m. on _____
(Date) (Date)

Shut-in pressure at ground surface _____ lbs. per sq. in. on _____
(Date)

Water is controlled by _____
(Cap, valve, etc.)

Township 11 S Range 2 W, W.M.
North

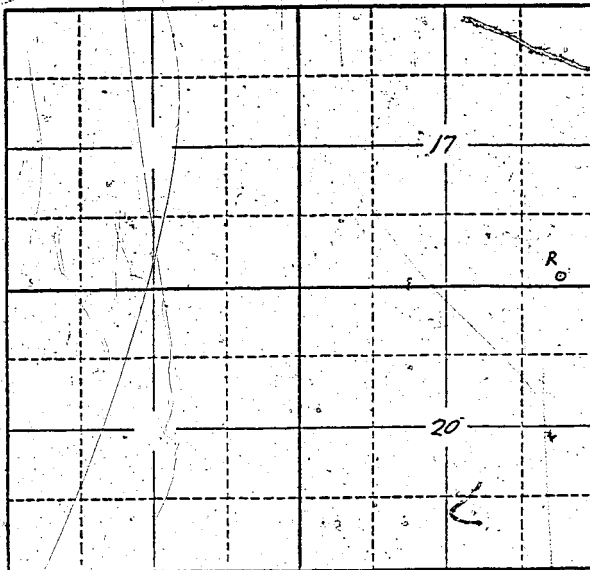

Locate well and acreage of irrigated land on plat.
Scale: 2" = 1 Mile

STATE OF OREGON

County of LINN

} ss.

I, Fred V. Kropf, being first duly ^{affirm} sworn, do hereby certify that I have read the foregoing Registration Statement and that all of the items therein contained are true to the best of my knowledge and belief.

Fred V. Kropf
(Signature of Registrant)

Subscribed and sworn to before me this 18 day of April, 1958

My commission expires 7/16/61

(Notary Public)

(SEAL)

CERTIFICATE OF REGISTRATION

STATE OF OREGON

County of Marion

} ss.

This is to certify that the foregoing Registration Statement was received in the office of the State Engineer on the 22nd day of May, 1958, at 6:00 o'clock A. M. and has been duly recorded in said office in Book No. 7 of Registration Statements on page GR-1543

Witness my hand this 1st day of December, 1958

Lucretia A. Dittus
(State Engineer)

By _____ (Deputy)

\$15.00