

Registration No. GR 1598

Certificate No. GR 1550

### Registration Statement

#### OF CLAIMANT OF RIGHT TO APPROPRIATE GROUND WATER

TO THE STATE ENGINEER OF OREGON:

I, Donald J La Motte  
of Box 6 Milton Freewater County of Umatilla  
(Mailing address)  
State of Oregon, do hereby make application for a certificate of registration as evidence of a right to appropriate ground water.

- 1. Source from which water is withdrawn is Dug Well  
(Flowing well, pump well, irrigation trench, or tunnel)
- 2. Location is: 1 1/2 Miles NW Milton Freewater  
(Approximate distance and direction from nearest city or town)

and is more particularly described as follows:

(a) 470 1/2' West, 1010' North of SE Corner of SW 1/4  
(Give distance and bearing to corner of section or other legal subdivision)  
being within SE 1/4 of SW 1/4 of Sec. 34, Twp. 6N, Rge. 35E  
(Smallest legal subdivision) (N. or S.) (E. or W.)

or (b) within limits of recorded platted property, town or city:  
in Lot 5, Block \_\_\_\_\_ of Vert's Pleasantview Addn  
(Name of plat or addition)  
County of Umatilla  
(If within city or town, give name)

3. Construction Work was begun on Prior to 1916; was completed on 1916  
(Date) (Date)

and the ground water claimed was first used for the purposes set out below on 1916  
(Date)  
since which time the water has been used Continuously  
(Continuously or intermittently)  
from 1916 to 1958  
(Date) (Date)

4. Quantity of water claimed and used is 50 gallons per minute; 4 acre feet per year.

5. Purpose or Purposes for which water is used Irrigation

6. Description of Well: Depth 48 feet. Type Dug  
(Domestic, irrigation, municipal, manufacturing, industrial, etc.) (Dug or drilled)  
diameter 6' x 6' inches. Elevation of ground at well site 875 feet, mean sea level.  
(As near as known)  
Depth to water table 40 feet.

7. Capacity of Well: 50 g.p.m. with 2-4 feet drawdown.  
\_\_\_\_\_ g.p.m. with \_\_\_\_\_ feet drawdown.

Date of test \_\_\_\_\_

If Flowing Well: Measured discharge \_\_\_\_\_ g.p.m. on \_\_\_\_\_  
(Date)


Shut-in pressure at ground surface \_\_\_\_\_ lbs. per sq. in. on \_\_\_\_\_  
(Date)

Water is controlled by \_\_\_\_\_  
(Cap, valve, etc.)





Township 6N Range 35E, W.M.  
North

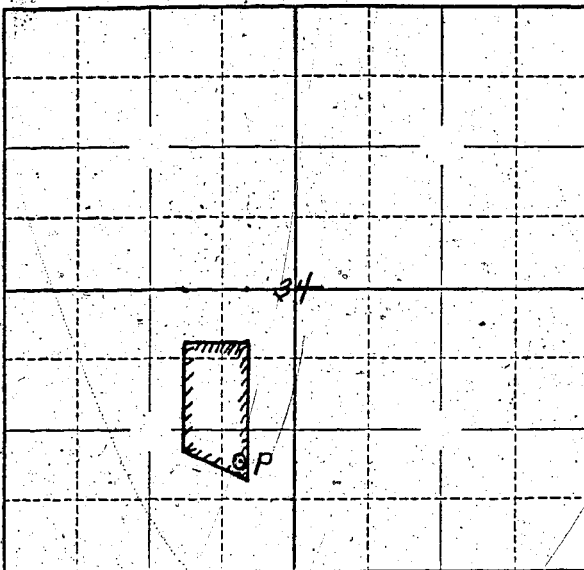

Locate well and acreage of irrigated land on plat.  
Scale: 4 - 1 Mile

STATE OF OREGON }  

I, \_\_\_\_\_, being first duly sworn, do hereby certify that I have read the foregoing Registration Statement and that all of the items therein contained are true to the best of my knowledge and belief.

(Signature of Registrant)

Subscribed and sworn to before me this \_\_\_\_\_ day of \_\_\_\_\_, 19\_\_\_\_.

My commission expires \_\_\_\_\_ (Notary Public)

(SEAL)

**CERTIFICATE OF REGISTRATION**

STATE OF OREGON }  
County of Marion } ss.

This is to certify that the foregoing Registration Statement was received in the office of the State Engineer on the 21st day of May, 1958 at 6:00 o'clock P.M. and has been duly recorded in said office in Book No. 7 of Registration Statements on page GR-1550

Witness my hand this 1st day of December, 1958

Leura B. Blanton  
(State Engineer)

By \_\_\_\_\_ (Deputy)

\$15.00