

RECEIVED
MAY 27 1959
STATE ENGINEER
SALEM, OREGON

REGISTRATION NO. GR-1599
CERTIFICATE NO. GR-2172

Registration Statement

OF CLAIMANT OF RIGHT TO APPROPRIATE GROUND WATER

(Under Chapter 708, Oregon Laws 1955.)

RECEIVED
MAY 29 1959
STATE ENGINEER
SALEM, OREGON

TO THE STATE ENGINEER OF OREGON:

I, Carl Barber
of Aurora Rt. 2 Box 135 County of Clackamas

State of Oregon, do hereby make application for a certificate of registration as evidence of a right to appropriate ground water.

- 1. Source from which water is withdrawn is Pump Well
(Flowing well, pump well, infiltration trench, or tunnel)
- 2. Location is: 3 Miles N. W. of Aurora
(Approximate distance and direction from nearest city or town)

and is more particularly described as follows: Beginning at corner of sect 34-35-3-2
700 feet east of 1120th N. from SW corner of Sec 35

(a) Beginning @ S.W. corner of W. 1/4 of
(Give distance and bearing to corner of section or other legal subdivision)
being within 660 ft. E. then 1200 ft. N. Sec. 35, Twp. 3. S., Rge. 1. W.
(Smallest legal subdivision) (N. or S.) (E. or W.)

or (b) within limits of recorded platted property, town or city:
in Lot _____, Block _____ of _____
(Name of plat or addition)

County of _____
(If within city or town, give name)

- 3. Construction Work was begun on Aug 20, 1956; was completed on Sept 23, 1956
(Date) (Date)

and the ground water claimed was first used for the purposes set out below on May 15, 1951
(Date)

since which time the water has been used Every Summer
(Continuously or Intermittently)
from May to Oct
(Date) (Date)

- 4. Quantity of water claimed and used is 300 gallons per minute; _____ acre feet per year.

5. Purpose or Purposes for which water is used to irrigate pasture
(Domestic, irrigation, municipal, manufacturing, industrial, etc.)

- 6. Description of Well: Depth 160 feet. Type Dug Well
(Dug or drilled)

diameter 10 inches. Elevation of ground at well site 150 feet, mean sea level.
(As near as known)

Depth to water table 23 feet.

- 7. Capacity of Well: 325 g.p.m. with 13.5 feet drawdown.
_____ g.p.m. with _____ feet drawdown.

Date of test Sept 23, 1956

If Flowing Well: Measured discharge _____ g.p.m. on _____
(Date)

Shut-in pressure at ground surface _____ lbs. per sq. in. on _____
(Date)

Water is controlled by _____
(Cap, valve, etc.)

8. Casing: (Give diameter, commercial specifications and depth below ground surface of each casing size.)

10" inch diameter from 0 to 176 feet
 inch diameter from to feet
 inch diameter from to feet
 inch diameter from to feet

Describe and show depth of shoe, plug, adapter, liner or other details:

9. Perforated Casings or Screens:

6" perforated from 153 to 176
 (Number per foot and size of perforations, or describe screen)
 from to
 from to
 from to

10. Log of Well: (Describe each stratum or formation clearly, indicate if water bearing, and give thickness and depth as indicated.)

MATERIAL	Thickness (Feet)	Depth to Bottom (Feet)
Surface	4	176-172
Surface clay	34	172-138
Surface sand	4	172-168
Yellow clay	37	164-127
Gray clay	7	127-120
Light brown clay	15	120-105
Blue clay	12	105-93
Light yellow clay	16	93-77
Blue clay	11	77-66
Black sand (water)	10	66-56
Gray clay	11	56-45
Blue clay	14	45-31
Sand & gravel	6	31-25
Blue clay	2	25-23
Dark brown & gray sand & gravel	2	23-21

If log of well is not available, give name and address of driller.

11. Infiltration Trench: Covered or open

Dimensions: Length ft. Minimum depth ft. Maximum depth ft.

Bottom width ft. Discharge g.p.m. Date of test

12. Tunnel: Type of lining

Dimensions:
(Length, course, and cross sectional size)

Position of water bearing stratum with reference to portal of tunnel

Log of tunnel: (Preceding table for log of well may be used, if desired. Give footage from portal and character of materials, as pertinent.)

13. Pumping Equipment:

(a) Pump *Pearless Turbine* Capacity *325* g.p.m.
(Make, type and size)


(b) Motor *30 H.P.*
(Type and horsepower)

14. Location of area irrigated or to be irrigated, or place of use if for purposes other than irrigation.

Township North or South	Range E. or W. of Willamette Meridian	Section	Forty-acre Tract	Number Acres To Be Irrigated	Date of Reclamation
3. S.	1. W.	35	N.W. 1/4 S.W. 1/4	31	1951
3. S.	1. W.	35	S.W. 1/4 S.W. 1/4	9	"
				40	"

15. If the ground water supply is supplemental to an existing water supply, identification of any application for a permit, permit, certificate or adjudicated right to appropriate water made or held by the registrant.

Township 35 Range NW, W.M.
North

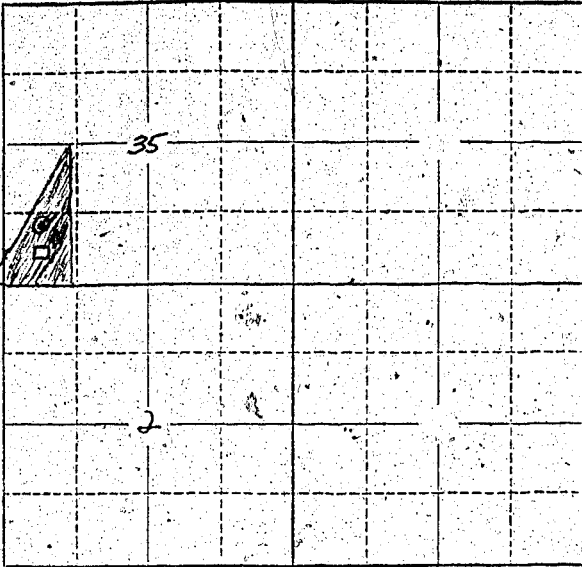

Locate well and acreage of irrigated land on plat.
Scale: 2" = 1 Mile

STATE OF OREGON

County of Marion } ss.

I, Carl Barber, being first duly sworn, do hereby certify that I have read the foregoing Registration Statement and that all of the items therein contained are true to the best of my knowledge and belief.

Carl Barber
(Signature of Registrant)

Subscribed and sworn to before me this 16 day of February, 1959.

My commission expires _____
NOTARY PUBLIC FOR OREGON
(Notary Public)

(SEAL) My Commission Expires May 24, 1959

CERTIFICATE OF REGISTRATION

STATE OF OREGON

County of Marion } ss.

This is to certify that the foregoing Registration Statement was received in the office of the State Engineer on the 23rd day of May, 1958, at 8:00 o'clock A.M. and has been duly recorded in said office in Book No. 10 of Registration Statements on page GR 2172.

~~Conditions shall be completed by _____ and the order completely published~~
~~_____~~

Witness my hand this 10th day of March, 1959.

Levia A. Stanley
(State Engineer)

By _____ (Deputy)

\$16.50

GR-2172