

Registration Statement**OF CLAIMANT OF RIGHT TO APPROPRIATE GROUND WATER**

(Under Chapter 708, Oregon Laws 1955.)

TO THE STATE ENGINEER OF OREGON:

I, H. P. Hamilton RTC Box 397
 of Salem County of Mason

State of Oregon, do hereby make application for a certificate of registration as evidence of a right to appropriate ground water.

1. Source from which water is withdrawn is Pump well
(Flowing well, pump well, infiltration trench, or tunnel)

2. Location is: 8 mi West from Salem
(Approximate distance and direction from nearest city or town)

and is more particularly described as follows:

(a) 1122' W. & 280' S. from SW corner of the N1/4 of William Greenwood, Dec
(Give distance and bearing to corner of section or other legal subdivision)

being within NW 1/4 NW 1/4 of Sec. 11, Twp. 7 S, Rge. 2 W
(Smallest legal subdivision) (N or S) (E or W)

or (b) within limits of recorded platted property, town or city:

in Lot _____, Block _____ of _____
(Name of plat or addition)

(If within city or town, give name)

County of _____

3. Construction Work was begun on 4-1-52, was completed on 5-1-52
(Date) (Date)

and the ground water claimed was first used for the purposes set out below on 5-1-52
(Date)

since which time the water has been used continuously
(Continuously or Intermittently)

from 1952 to 1955
(Date) (Date)

4. Quantity of water claimed and used is 200 gallons per minute; _____ acre feet per year.

5. Purpose or Purposes for which water is used irrigation

(Domestic, irrigation, municipal, manufacturing, industrial, etc.)

6. Description of Well: Depth 135 feet. Type drilled
(Dug or drilled)

diameter 8 inches. Elevation of ground at well site 950 feet, mean sea level.
(As near as known)

Depth to water table 40 feet.

7. Capacity of Well: 200 g.p.m. with _____ feet drawdown.

_____ g.p.m. with _____ feet drawdown.

Date of test 5-1-52

If Flowing Well: Measured discharge _____ g.p.m. on _____
(Date)

Shut-in pressure at ground surface _____ lbs. per sq. in. on _____
(Date)

Water is controlled by valve
(Cap, valve, etc.)

8 inch diameter from 117 to 135 feet
 inch diameter from to feet
 inch diameter from to feet
 inch diameter from to feet

Describe and show depth of shoe, plug, adapter, liner or other details: _____

2.0 ft of perforations from _____ to _____
(Number per foot and size of perforations, or describe screen)

_____ from _____ to _____

_____ from _____ to _____

_____ from _____ to _____

10. Log of Well: (Describe each stratum or formation clearly, indicate if water bearing, and give thickness and depth as indicated.)

[illegible]

Stadel

Silverton Oregon

11. Infiltration Trench: Covered or open

Dimensions: Length 2.12 ft. Minimum depth 0.1 ft. Maximum depth 0.1 ft.

Bottom width..... ft. Discharge..... g.p.m. Date of test

12. Tunnel: Type of lining

Dimensions: _____
(Length, course, and cross sectional size)

Position of water bearing stratum with reference to portal of tunnel.....

Log of tunnel: (Preceding table for log of well may be used, if desired. Give footage from portal and character of materials, as pertinent.)

13. Pumping Equipment:

(a) Pump Beckley Turbine 3021-6" Capacity 200 g.p.m.
(Make, type and size)


(b) Motor 3 phase - non Reverse - Vertical Hollow Shaft 15 h.p.
(Type and horsepower)

14. Location of area irrigated or to be irrigated, or place of use if for purposes other than irrigation.

[illegible]

15. If the ground water supply is supplemental to an existing water supply, identification of any application for a permit, permit, certificate or adjudicated right to appropriate water made or held by the registrant.

Township 7 Range 24 W.M.
North

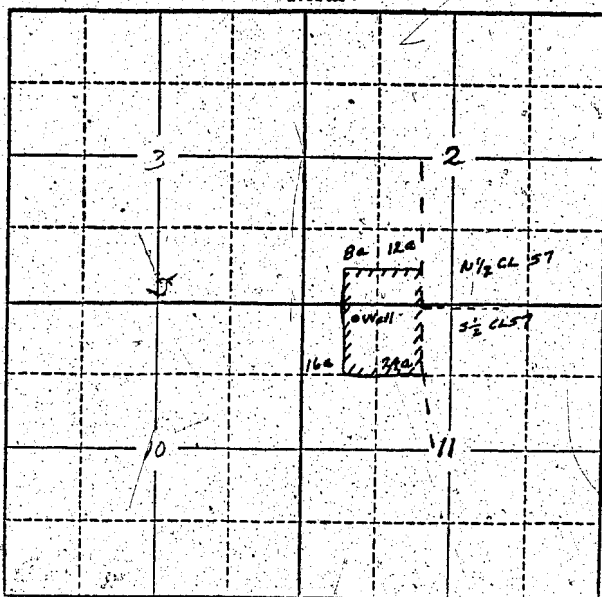

Locate well and acreage of irrigated land on plat.

Scale: 2" = 1 Mile

STATE OF OREGON

County of Marion

I, H. P. Hansen

being first duly sworn, do hereby certify that I have read the foregoing Registration Statement and that all of the items therein contained are true to the best of my knowledge and belief.

H. P. Hansen
(Signature of Registrant)

Subscribed and sworn to before me this 23 day of Sept, 1955

My commission expires April 6 1959

Wm. Bliven
(Notary Public)

(SEAL)

CERTIFICATE OF REGISTRATION

STATE OF OREGON

County of Marion

This is to certify that the foregoing Registration Statement was received in the office of the State Engineer on the 28 day of September, 1955, at 9:20 o'clock A. M. and has been duly recorded in said office in Book No. 1 of Registration Statements on page 13

Construction ~~shall be~~ ^{is} completed by 10, and the water ^{is} completely applied to beneficial use by 19

Witness my hand this 24th day of February, 1956

Lewis A. Stanley
(State Engineer)

By

(Deputy)