

# Registration Statement

REGISTRATION NO. GR-1605CERTIFICATE NO. GR-1557

## OF CLAIMANT OF RIGHT TO APPROPRIATE GROUND WATER

(Under Chapter 708, Oregon Laws 1955.)

TO THE STATE ENGINEER OF OREGON:

I, Honoras H. T. Margarita O. Falphs  
of Aumsville County of MarionState of Oregon, do hereby make application for a certificate of registration as evidence of a right to appropriate ground water.1. Source from which water is withdrawn is Pumped #2  
(Flowing well, pump well, infiltration trench, or tunnel)2. Location is: 5 Miles South of Aumsville  
(Approximate distance and direction from nearest city or town)

and is more particularly described as follows:

(a) Bearing as Computed N6°56'54" for 2,662.8 ft. from S.E. Corner Sec. 24  
2,643.2' North T. 322.1' West of the S.E. Corner Sec. 24  
(Give distance and bearing to corner of section or other legal subdivision)being within SE 1/4 NE 1/4 of Sec. 24, Twp. 9 S., Rge. 2 W.  
(Smallest legal subdivision) (S., or S.) (E., or W.)

or (b) within limits of recorded platted property, town or city:

in Lot \_\_\_\_\_, Block \_\_\_\_\_ of \_\_\_\_\_  
(Name of plat or addition)County of Marion  
(If within city or town, give name)3. Construction Work was begun on 6-8-51; was completed on 6-11-51  
(Date) (Date)and the ground water claimed was first used for the purposes set out below on 6-11-51  
(Date)since which time the water has been used Continuously during Irrigation Season  
(Continuously or intermittent)from 6-11-51 to Present  
(Date) (Date)4. Quantity of water claimed and used is 280 gallons per minute; 87.5 acre  
~~422~~ feet per year.5. Purpose or Purposes for which water is used Irrigation  
(Domestic, irrigation, municipal, manufacturing, industrial, etc.)6. Description of Well: Depth 21 feet. Type drilled  
(Dug or drilled)diameter 8 inches. Elevation of ground at well site 371 feet, mean sea level.  
(As near as known)Depth to water table 11 feet.7. Capacity of Well: 450 g.p.m. with 7 feet drawdown. - 6-14-55225 g.p.m. with 7 feet drawdown. - 8-7-55Date of test See above

If Flowing Well: Measured discharge \_\_\_\_\_ g.p.m. on \_\_\_\_\_ (Date)

Shut-in pressure at ground surface \_\_\_\_\_ lbs. per sq. in. on \_\_\_\_\_ (Date)


Water is controlled by \_\_\_\_\_ (Cap. valve, etc.)

8/15/55





Township 9 S Range 2 W W.M.  
North

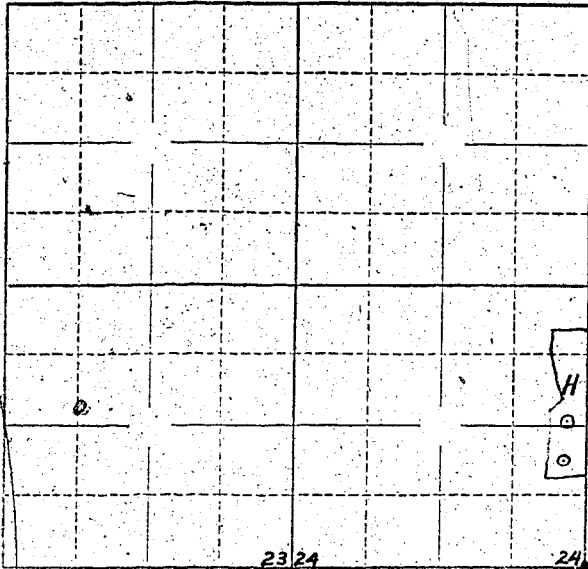

23 24 24 19  
26 25 25 30  
Locate well and acreage of irrigated land on plat.  
Scale: 2" = 1 Mile

STATE OF OREGON

County of Marion

ss.

I, Honor H. Ralph, being first duly sworn, do hereby certify that I have read the foregoing Registration Statement and that all of the items therein contained are true to the best of my knowledge and belief.

Honor H. Ralph  
(Signature of Registrant)

Subscribed and sworn to before me this 23rd day of May, 1958

My commission expires 12th June 1961

Wm. S. Besterman  
(Notary Public)

(SEAL)

CERTIFICATE OF REGISTRATION

STATE OF OREGON

County of Marion

ss.

This is to certify that the foregoing Registration Statement was received in the office of the State Engineer on the 23rd day of May, 1958, at 10:30 o'clock A. M. and has been duly recorded in said office in Book No. 7 of Registration Statements on page GR-1557

Witness my hand this 1st day of December, 1958

Reuben A. Allen  
(State Engineer)

By

(Deputy)

GR-1557

#15 1/2