

RECEIVED  
AUG 1 1956  
STATE ENGINEER  
SALEM, OREGON

Registration Statement

REGISTRATION NO. GR-161  
CERTIFICATE NO. GR-154

OF CLAIMANT OF RIGHT TO APPROPRIATE GROUND WATER

(Under Chapter 708, Oregon Laws 1955.)

TO THE STATE ENGINEER OF OREGON:

I, Max, Elizabeth and Clara Burkhart  
of Rt. 2, Box 216, Lebanon County of Linn

State of Oregon, do hereby make application for a certificate of registration as evidence of a right to appropriate ground water.

1. Source from which water is withdrawn is pump well 1  
(Flowing well, pump well, infiltration trench, or tunnel)

2. Location is: 3 miles north of Lebanon, Oregon  
(Approximate distance and direction from nearest city or town)

and is more particularly described as follows:

(a) No. 1 - N. 89° 57' E. 66.63 chains from NW corner D.L.C. 56  
(Give distance and bearing to corner of section or other legal subdivision)

being within SE 1/4 of SW 1/4 of Sec. 23, Twp. 11 S, Rge. 2 W  
(Smallest legal subdivision) (N. or S.) (E. or W.)

or (b) within limits of recorded platted property, town or city:

in Lot \_\_\_\_\_, Block \_\_\_\_\_ of \_\_\_\_\_  
(Name of plat or addition)

County of Linn  
(If within city or town, give name)

3. Construction Work was begun on May 10, 1953; was completed on May 14, 1953  
(Date) (Date)

and the ground water claimed was first used for the purposes set out below on June 15, 1953  
(Date)

since which time the water has been used Continuously  
(Continuously or Intermittently)

from June 15, 1953 to present time  
(Date) (Date)

4. Quantity of water claimed and used is 500 gallons per minute; .77 acre feet per year.

5. Purpose or Purposes for which water is used irrigation  
(Domestic, irrigation, municipal, manufacturing, industrial, etc.)

6. Description of Well: Depth 25 feet. Type drilled  
(Dug or drilled)

diameter 8 inches. Elevation of ground at well site 295 feet, mean sea level.  
(As near as known)

Depth to water table 10 feet.

7. Capacity of Well: 700 g.p.m. with 2 feet drawdown.

       g.p.m. with        feet drawdown.

Date of test \_\_\_\_\_

If Flowing Well: Measured discharge \_\_\_\_\_ g.p.m. on \_\_\_\_\_  
(Date)

Shut-in pressure at ground surface \_\_\_\_\_ lbs. per sq. in. on \_\_\_\_\_  
(Date)

Water is controlled by \_\_\_\_\_  
(Cap, valve, etc.)

8. Casing: (Give diameter, commercial specifications and depth below ground surface of each casing size.)

8 inch diameter steel casing from 0 to 25 feet  
 inch diameter from to feet  
 inch diameter from to feet  
 inch diameter from to feet

Describe and show depth of shoe, plug, adapter, liner or other details:

9. Perforated Casings or Screens:

All three casings perforated all the way from to  
 (Number per foot and size of perforations, or describe screen)  
 from to  
 from to  
 from to

10. Log of Well: (Describe each stratum or formation clearly, indicate if water bearing, and give thickness and depth as indicated.)

MATERIAL	Thickness (Feet)	Depth to Bottom (Feet)
Information not available		

If log of well is not available, give name and address of driller. J. R. Rucker, Lebanon, Oregon

11. Infiltration Trench: Covered or open .....  
 Dimensions: Length ..... ft. Minimum depth ..... ft. Maximum depth ..... ft.

Bottom width ..... ft. Discharge ..... g.p.m. Date of test .....

12. Tunnel: Type of lining .....

Dimensions: .....  
(Length, course, and cross sectional size)

Position of water bearing stratum with reference to portal of tunnel .....

Log of tunnel: (Preceding table for log of well may be used, if desired. Give footage from portal and character of materials, as pertinent.)

13. Pumping Equipment:

(a) Pump 3<sup>rd</sup> Fairbanks Morse centrifugal Capacity 600 g.p.m.  
(Make, type and size)


(b) Motor 15 H.P. electric  
(Type and horsepower)

14. Location of area irrigated or to be irrigated, or place of use if for purposes other than irrigation.

Township North or South	Range E. or W. of Willamette Meridian	Section	Forty-acre Tract	Number Acres To Be Irrigated	Date of Reclamation
11 S	2 W	23	NW $\frac{1}{4}$ of SW $\frac{1}{4}$	6.9	June 15, 1953
11 S	2 W	23	NE $\frac{1}{4}$ of SW $\frac{1}{4}$	6.9	"
11 S	2 W	23	SE $\frac{1}{4}$ of SW $\frac{1}{4}$	8.9	"
11 S	2 W	23	SW $\frac{1}{4}$ of SW $\frac{1}{4}$	8.3	"
				31.0	

15. If the ground water supply is supplemental to an existing water supply, identification of any application for a permit, permit, certificate or adjudicated right to appropriate water made or held by the registrant.

Township 115 Range 2W, W.M.  
North

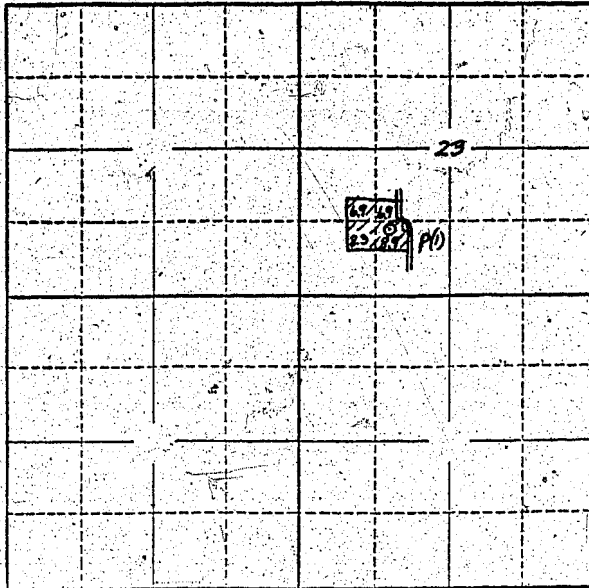

Locate well and acreage of irrigated land on plat.  
Scale: 2" = 1 Mile

STATE OF OREGON

County of Linn

ss.

I, Max, Elizabeth and Clara Burkhart, being first duly sworn, do hereby certify that I have read the foregoing Registration Statement and that all of the items therein contained are true to the best of my knowledge and belief.

Max Burkhart  
Clara Burkhart  
Elizabeth Burkhart  
(Signature of Registrant)

Subscribed and sworn to before me this 27th day of July, 1956

My commission expires July 13, 1958

Alta Wilson  
(Notary Public)

(SEAL)

**CERTIFICATE OF REGISTRATION**

STATE OF OREGON

County of Marion

ss.

This is to certify that the foregoing Registration Statement was received in the office of the State Engineer on the 7th day of August, 1956, at 8 o'clock A.M. and has been duly recorded in said office in Book No. 1 of Registration Statements on page GR-154 C

~~Construction shall be completed by \_\_\_\_\_, 19\_\_\_\_, and the water completely applied to beneficial use by \_\_\_\_\_, 19\_\_\_\_.~~

Witness my hand this 8th day of October, 1956

Leuris A. Stanley  
(State Engineer)

By \_\_\_\_\_  
(Deputy)

GR-154 C