

Registration Statement

REGISTRATION NO. GR-1610

CERTIFICATE NO. GR-1562

OF CLAIMANT OF RIGHT TO APPROPRIATE GROUND WATER

(Under Chapter 708, Oregon Laws 1955.)

TO THE STATE ENGINEER OF OREGON:

I, Margaret Isclanner Loucks of 3030 River Bend Rd., County of Polk

State of Oregon, do hereby make application for a certificate of registration as evidence of a right to appropriate ground water.

1. Source from which water is withdrawn is Pump Well (Flowing well, pump well, infiltration trench, or tunnel)

2. Location is: 3 mile north or west of town (Approximate distance and direction from nearest city or town)

and is more particularly described as follows:

(a) 1930 feet S 7° E from NW corner of Sec. 10 T. 7 S. R. 3 W (Give distance and bearing to corner of section or other legal subdivision)

being within SW 1/4 of NW 1/4 of Sec. 10, Twp. 7 S, Rge. 3 W (Smallest legal subdivision) (N. or S.) (E. or W.)

or (b) within limits of recorded platted property, town or city:

in Lot Block of (Name of plat or addition)

(If within city or town, give name) County of Polk

3. Construction Work was begun on May 1972; was completed on (Date) (Date)

and the ground water claimed was first used for the purposes set out below on (Date)

since which time the water has been used Continuously (Continuously or intermittently)

from (Date) to (Date)

4. Quantity of water claimed and used is 250 gallons per minute; 7 acre feet per year.

5. Purpose or Purposes for which water is used Irrigation (Domestic, irrigation, municipal, manufacturing, industrial, etc.)

6. Description of Well: Depth 27 feet, Type Dug (Dug or drilled)

diameter 8 inches. Elevation of ground at well site 170 feet, mean sea level. (As near as known)

Depth to water table 15 feet.

7. Capacity of Well: 250 g.p.m. with 10 foot drawdown.

g.p.m. with 10 foot drawdown.


Date of test May 1972

If Flowing Well: Measured discharge g.p.m. on (Date)

Shut-in pressure at ground surface lbs. per sq. in. on (Date)

Water is controlled by (Cap, valve, etc.)

Township 75 Range 3W, W.M.
North

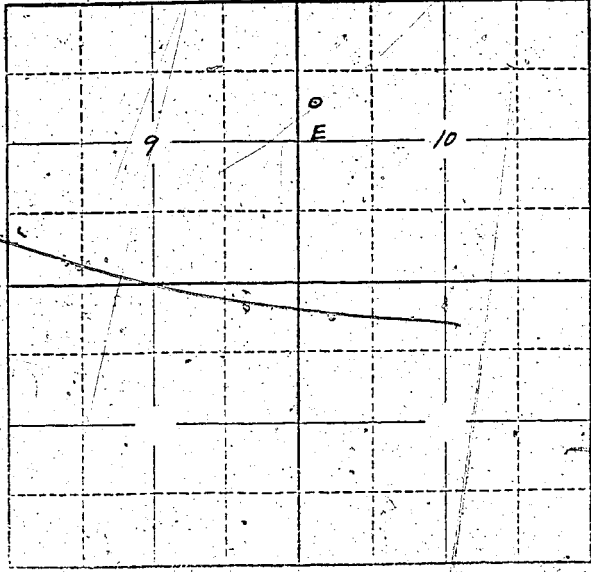

Locate well and acreage of irrigated land on plat:
Scale: 2" = 1 Mile

STATE OF OREGON }
County of Marion } ss.

I, Margaret Techauner Loucks, being first duly sworn, do hereby certify that I have read the foregoing Registration Statement and that all of the items therein contained are true to the best of my knowledge and belief.

Margaret Techauner Loucks
(Signature of Registrant)

Subscribed and sworn to before me this 26th day of May, 1958

My commission expires 12th June 1961 Wm. J. Bartholomew
(Notary Public)

(SEAL)

CERTIFICATE OF REGISTRATION

STATE OF OREGON }
County of Marion } ss.

This is to certify that the foregoing Registration Statement was received in the office of the State Engineer on the 26th day of May, 1958, at 12:00 o'clock A. M. and has been duly recorded in said office in Book No. 7 of Registration Statements on page GR-1562

~~Construction shall be completed by 1958 which was completed by 1958~~

~~Construction shall be completed by 1958~~

Witness my hand this 1st day of December, 1958
Lewis C. [Signature]
(State Engineer)

\$1500

By _____
(Deputy)

GR-1562