

# Registration Statement

REGISTRATION NO. GR-1614  
CERTIFICATE NO. GR-1571

## OF CLAIMANT OF RIGHT TO APPROPRIATE GROUND WATER

(Under Chapter 708, Oregon Laws 1955.)

TO THE STATE ENGINEER OF OREGON:

I, Ed Budreau of Hubbard Ore RFD

of \_\_\_\_\_ County of Marion

State of Oregon, do hereby make application for a certificate of registration as evidence of a right to appropriate ground water.

1. Source from which water is withdrawn is Pump  
(Flowing well, pump well, infiltration trench, or tunnel)

2. Location is: 2 1/2 miles north east Hubbard Ore  
(Approximate distance and direction from nearest city or town)

and is more particularly described as follows:

(a) 1600' S & 1900' W from NE Corner Section 26  
(Give distance and bearing to corner of section or other legal subdivision)

being within SW 1/4 NE 1/4 of Sec. 26, Twp. 45, Rge. 1W  
(Smallest legal subdivision) (S. or S.) (E. or W.)

or (b) within limits of recorded platted property, town or city:

in Lot \_\_\_\_\_, Block \_\_\_\_\_ of \_\_\_\_\_  
(Name of plat or addition)

(If within city or town, give name)

County of \_\_\_\_\_

3. Construction Work was begun on June 1950, was completed on July 1950  
(Date) (Date)

and the ground water claimed was first used for the purposes set out below on June 1951  
(Date)

since which time the water has been used Intermittently  
(Continuously or Intermittently)

from June to through September  
(Date) (Date)

4. Quantity of water claimed and used is 320 gallons per minute; \_\_\_\_\_ acre feet per year.

5. Purpose or Purposes for which water is used Irrigation

(Domestic, irrigation, municipal, manufacturing, industrial, etc.)

6. Description of Well: Depth 133 feet. Type Aug. drilled  
(Dug or drilled)

diameter 10 inches. Elevation of ground at well site \_\_\_\_\_ feet, mean sea level.  
(As near as known)

Depth to water table \_\_\_\_\_ feet.

7. Capacity of Well: 650 g.p.m. with 95 feet drawdown.

\_\_\_\_\_ g.p.m. with \_\_\_\_\_ feet drawdown.

Date of test 1950

If Flowing Well: Measured discharge \_\_\_\_\_ g.p.m. on \_\_\_\_\_  
(Date)

Shut-in pressure at ground surface \_\_\_\_\_ lbs. per sq. in. on \_\_\_\_\_  
(Date)

Water is controlled by \_\_\_\_\_  
(Cap. valve, etc.)

size.)

10

Describe and show depth of shoe, plug, adapter, liner or other details: .....

### 9. Perforated Casings or Screens:

(Number per foot and size of perforations, or describe screen)

(Number per foot and size of perforations, or describe screen)

Gravel packed & perforated

10. **Log of Well:** (Describe each stratum or formation clearly, indicate if water bearing, and give thickness and depth as indicated.)

[illegible]


GR-1571

Coleridge

- ### Position of water bearing stratum with reference to portal of tunnel

S $\frac{1}{2}$  Section 23 & N $\frac{1}{4}$  section 26

Township 4S Range 1W W.M.

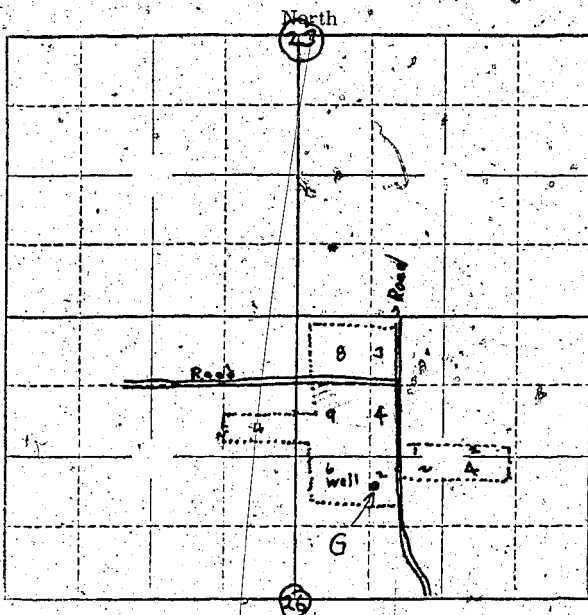

Locate well and acreage of irrigated land on plat.

Scale: 1" = 1 Mile

STATE OF OREGON

County of CLACKAMAS

I, ED BUREAU, being first duly sworn, do hereby certify that I have read the foregoing Registration Statement and that all of the items therein contained are true to the best of my knowledge and belief.

(Signature of Registrant)

Subscribed and sworn to before me this 17th day of April, 1958

My commission expires December 7th, 1961

(Notary Public)

(SEAL)

### CERTIFICATE OF REGISTRATION

STATE OF OREGON

County of Marion

This is to certify that the foregoing Registration Statement was received in the office of the State Engineer on the 27 day of May, 1958, at 8:00 o'clock A.M. and has been duly recorded in said office in Book No. 7 of Registration Statements on page GR-1571.

~~Construction shall be completed by 1959 and the water completely applied to beneficial use by 1960.~~

Witness my hand this 1st day of December, 1958

(State Engineer)

By

(Deputy)

GR-1571