

RECEIVED
MAY 27 1958
STATE ENGINEER

Registration No. GR - 1617

Certificate No. GR - 1575

Registration Statement

OF CLAIMANT OF RIGHT TO APPROPRIATE GROUND WATER

TO THE STATE ENGINEER OF OREGON:

I, Bryan and Mildred Smith
of Route 1, Harrisburg County of Linn
(Mailing address)
State of Oregon, do hereby make application for a certificate of registration as evidence
of a right to appropriate ground water.

1. Source from which water is withdrawn is Pump well No. 1
(Flowing well, pump well, infiltration trench, or tunnel)
2. Location is: 5 1/2 miles south of Harrisburg, Oregon
(Approximate distance and direction from nearest city or town)

and is more particularly described as follows:

(a) N. 35° 20' W. 12 chains from SE corner of S. 34, T. 15 S., R. 4 W.
(Give distance and bearing to corner of section or other legal subdivision)
being within SE 1/4 of SE 1/4 of Sec. 34, Twp. 15 S, Rge. 4 W.
(Smallest legal subdivision) (N. or S.) (E. or W.)

or (b) within limits of recorded platted property, town or city:
in Lot _____, Block _____ of _____
(Name of plat or addition)
County of Linn
(If within city or town, give name)

3. Construction Work was begun on 1940; was completed on 1940
(Date) (Date)
and the ground water claimed was first used for the purposes set out below on 1940
(Date)
since which time the water has been used continuously
(Continuously or Intermittently)
from 1940 to present time
(Date) (Date)

4. Quantity of water claimed and used is 600 gallons per minute; 132.5 acre feet per year.

5. Purpose or Purposes for which water is used Irrigation
(Domestic, irrigation, municipal, manufacturing, industrial, etc.)

6. Description of Well: Depth 14 feet. Type Dug
(Dug or drilled)
diameter 4 1/2 inches. Elevation of ground at well site 325 feet, mean sea level.
(As near as known)
Depth to water table 7 feet.

7. Capacity of Well: 600 g.p.m. with 3 feet drawdown.
 g.p.m. with feet drawdown.


Date of test While pumping

If Flowing Well: Measured discharge g.p.m. on
(Date)

Shut-in pressure at ground surface lbs. per sq. in. on
(Date)

Water is controlled by
(Cap, valve, etc.)

Township 15 & 16 S Range 1 E W.M.
North

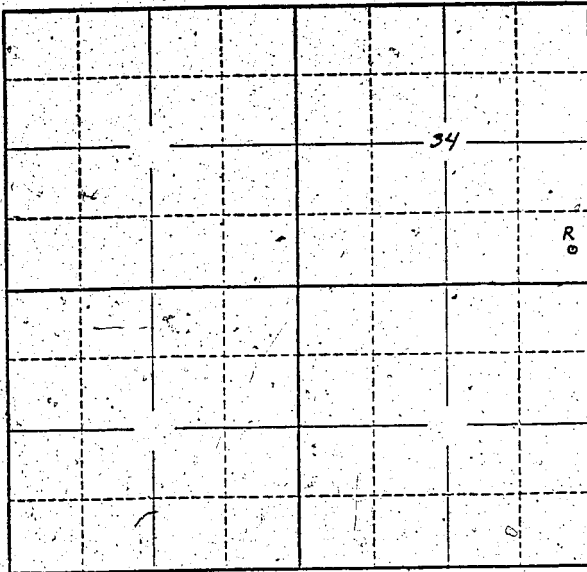

Locate well and acreage of irrigated land on plat.
Scale: 2" = 1 Mile

STATE OF OREGON

County of LINN

} ss.

I, Bryan and Mildred Smith, being first duly sworn, do hereby certify that I have read the foregoing Registration Statement and that all of the items therein contained are true to the best of my knowledge and belief.

(Signature of Registrant)

Subscribed and sworn to before me this 22nd day of May, 1958

My commission expires August 13, 1958

(Notary Public)

(SEAL)

CERTIFICATE OF REGISTRATION

STATE OF OREGON

County of Marion

} ss.

This is to certify that the foregoing Registration Statement was received in the office of the State Engineer on the 27th day of May, 1958, at 6:00 o'clock A.M. and has been duly recorded in said office in Book No. 7 of Registration Statements on page GR-1575

Witness my hand this 1st day of December, 1958

(State Engineer)

By (Deputy)

GR-1575

4/18/45