

Registration No. GR - 1620

Certificate No. GR - 1578

Registration Statement

OF CLAIMANT OF RIGHT TO APPROPRIATE GROUND WATER

TO THE STATE ENGINEER OF OREGON:

I, CLARENCE L. AND EDNA M. BRIGGS

of JUNCTION CITY, Oregon Route 3, County of LANE
(Mailing address)

State of Oregon, do hereby make application for a certificate of registration as evidence of a right to appropriate ground water.

1. Source from which water is withdrawn is Pump Well #2
(Flowing well, pump well, infiltration trench, or tunnel)

2. Location is: 4 MILES NORTH of JUNCTION CITY, Oregon
(Approximate distance and direction from nearest city or town)

and is more particularly described as follows:

(a) 45 FT N 1/2 E 1330 FT W from the SE Corner of Section 7
(Give distance and bearing to corner of section or other legal subdivision)

being within S 1/4 SE 1/4 of Sec. 7, Twp. 15 S, Rge. 4 W
(Smallest legal subdivision) (N. or S.) (E. or W.)

or (b) within limits of recorded platted property, town or city:

in Lot _____, Block _____ of _____
(Name of plat or addition)

County of _____
(If within city or town, give name)

3. Construction Work was begun on 1953; was completed on 1953
(Date) (Date)

and the ground water claimed was first used for the purposes set out below on 1953
(Date)

since which time the water has been used Continuously
(Continuously or intermittently)

from JULY to OCTOBER
(Date) (Date)

4. Quantity of water claimed and used is 500 gallons per minute; unknown acre feet per year.

5. Purpose or Purposes for which water is used irrigated row crops

(Domestic, irrigation, municipal, manufacturing, industrial, etc.)

6. Description of Well: Depth 20 feet. Type Dug
(Dug or drilled)

diameter 10 inches. Elevation of ground at well site _____ feet, mean sea level.
(As near as known)

Depth to water table 6 feet.

7. Capacity of Well: 550 g.p.m. with 12 feet drawdown.

unknown g.p.m. with unknown feet drawdown.


Date of test Oct 1953

If Flowing Well: Measured discharge _____ g.p.m. on _____
(Date)

Shut-in pressure at ground surface _____ lbs. per sq. in. on _____
(Date)

Water is controlled by _____
(Cap, valve, etc.)

Township 15S Range 4W, W.M.
North

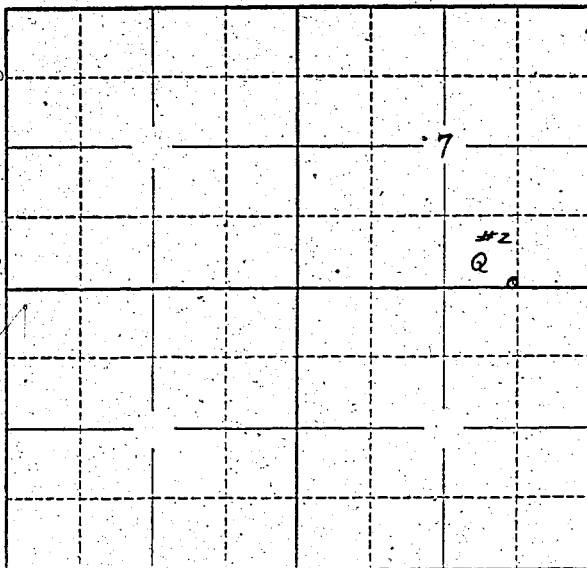

Locate well and acreage of irrigated land on plat.
Scale: 2" = 1 Mile

STATE OF OREGON
County of Lane } ss.

I, Mr. Clarence L. and Edna M. Briggs, being first duly sworn, do hereby certify that I have read the foregoing Registration Statement and that all of the items therein contained are true to the best of my knowledge and belief.

our

Clarence L. Briggs

Edna M. Briggs
(Signature of Registrant)

Subscribed and sworn to before me this 22d day of May, 1958

My commission expires Dec. 15, 1961.

Virginia M. Harris
(Notary Public)

(SEAL)

CERTIFICATE OF REGISTRATION

STATE OF OREGON
County of Marion } ss.

This is to certify that the foregoing Registration Statement was received in the office of the State Engineer on the 28th day of May, 1958, at 2:00 o'clock A. M. and has been duly recorded in said office in Book No. 7 of Registration Statements on page GR-1578

Witness my hand this 1st day of December, 1958

Lewis A. Stanley
(State Engineer)

By _____
(Deputy)

#15-30