

Registration Statement

OF CLAIMANT OF RIGHT TO APPROPRIATE GROUND WATER

TO THE STATE ENGINEER OF OREGON:

I, Edwin E. Moser

of Rte 1, Box 301, Sherwood County of C. LACKAMAS
(Mailing address)

State of Oregon, do hereby make application for a certificate of registration as evidence of a right to appropriate ground water.

1. Source from which water is withdrawn is Pump Well
(Flowing well, pump well, infiltration trench, or tunnel)

2. Location is: 3 miles NE of Wilsonville
(Approximate distance and direction from nearest city or town)

and is more particularly described as follows:

(a) S. 14° W, 2290 feet from NE CORNER SECTION 7.
(Give distance and bearing to corner of section or other legal subdivision)

being within SE 1/4 NE 1/4 of Sec. 7, Twp. 3S, Rge. 1E
(Smallest legal subdivision) (N. or S.) (E. or W.)

or (b) within limits of recorded platted property, town or city: _____

in Lot _____, Block _____ of _____
(Name of plat or addition)

County of _____
(If within city or town, give name)

3. Construction Work was begun on June-1948; was completed on June-1948
(Date) (Date)

and the ground water claimed was first used for the purposes set out below on June-1950
(Date)

since which time the water has been used Continuously throughout the summer
(Continuously or Intermittently)

from 1950 to Present
(Date) (Date)

4. Quantity of water claimed and used is 80 gallons per minute; _____ acre feet per year.

5. Purpose or Purposes for which water is used Irrigation

(Domestic, irrigation, municipal, manufacturing, industrial, etc.)

6. Description of Well: Depth 275 feet. Type Drilled
(Dug or drilled)

diameter 8 inches. Elevation of ground at well site _____ feet, mean sea level.
(As near as known)

Depth to water table 65 feet.

7. Capacity of Well: 100 g.p.m. with 200 feet drawdown.

_____ g.p.m. with _____ feet drawdown.


Date of test _____

If Flowing Well: Measured discharge _____ g.p.m. on _____
(Date)

Shut-in pressure at ground surface _____ lbs. per sq. in. on _____
(Date)

Water is controlled by _____
(Cap, valve, etc.)

Township 3S Range 1E, W.M.
North

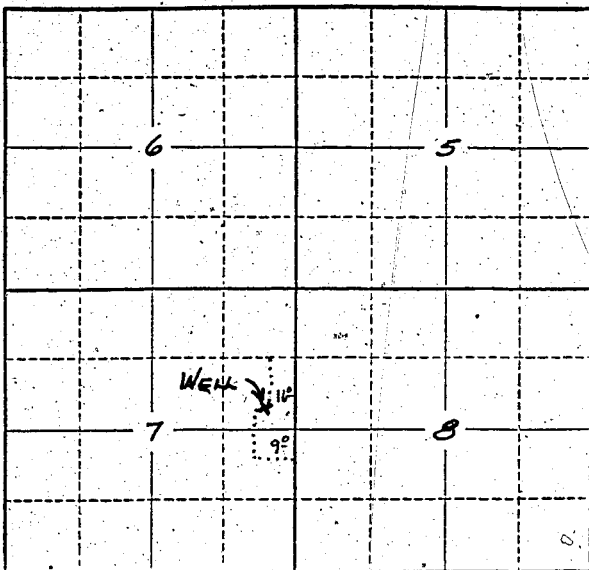

Locate well and acreage of irrigated land on plat.

Scale: 2" = 1/4 Mile

STATE OF OREGON

County of Clackamas } ss.

I, Edwin F. Moser, being first duly sworn, do hereby certify that I have read the foregoing Registration Statement and that all of the items therein contained are true to the best of my knowledge and belief.

Edwin F. Moser
(Signature of Registrant)

Subscribed and sworn to before me this 7th day of May, 1958

My commission expires March 27, 1961
(Notary Public)

(SEAL)

CERTIFICATE OF REGISTRATION

STATE OF OREGON

County of Marion } ss.

This is to certify that the foregoing Registration Statement was received in the office of the State Engineer on the 29th day of May, 1958, at 1:00 o'clock A. M. and has been duly recorded in said office in Book No. 7 of Registration Statements on page GR-1590

Witness my hand this 7th day of January, 1959

Henry A. Standen
(State Engineer)

\$15.00

By _____
(Deputy)

GR-1590