

REGISTERED  
MAY 24 1950  
STATE ENGINEER  
SALEM, OREGON

Registration No. GR. 1627  
Certificate No. GR. 1591

# Registration Statement

## OF CLAIMANT OF RIGHT TO APPROPRIATE GROUND WATER

TO THE STATE ENGINEER OF OREGON:

I, Gerald W. and Marie Detaring

of Harrisburg County of Linn

State of Oregon, do hereby make application for a certificate of registration as evidence of a right to appropriate ground water.

1. Source from which water is withdrawn is Pump Well No. 3  
(Flowing well, pump well, infiltration trench, or tunnel)
2. Location is: 7 miles south of Harrisburg, Oregon  
(Approximate distance and direction from nearest city or town)

and is more particularly described as follows:

(a) S. 2046' and East 660' from SW corner of NW 1/4, S. 12, T. 16 S., R. 14 W.  
(Give distance and bearing to corner of section or other legal subdivision)

being within SW 1/4 of SW 1/4 of Sec. 12, Twp. 16 S., Rge. 14 W.  
(Smallest legal subdivision) (N. or S.) (E. or W.)

or (b) within limits of recorded platted property, town or city:

in Lot \_\_\_\_\_, Block \_\_\_\_\_ of \_\_\_\_\_  
(Name of plat or addition)

County of Lane

(If within city or town, give name)

3. Construction Work was begun on March 1940; was completed on March 1940  
(Date) (Date)

and the ground water claimed was first used for the purposes set out below on May 1940  
(Date)

since which time the water has been used continuously  
(Continuously or intermittently)

from May 1940 to present time  
(Date) (Date)

4. Quantity of water claimed and used is 500 gallons per minute; 43.75 acre feet per year.

5. Purpose or Purposes for which water is used Irrigation

(Domestic, irrigation, municipal, manufacturing, industrial, etc.)

6. Description of Well: Depth 25 feet. Type Driven  
(Dug or drilled)

diameter 2-1/4 inches. Elevation of ground at well site 340 feet, mean sea level.  
(As near as known)

Depth to water table 12 feet.

7. Capacity of Well: \_\_\_\_\_ g.p.m. with \_\_\_\_\_ feet drawdown.  
\_\_\_\_\_ g.p.m. with \_\_\_\_\_ feet drawdown.

Date of test Not tested

If Flowing Well: Measured discharge \_\_\_\_\_ g.p.m. on \_\_\_\_\_  
(Date)

Shut-in pressure at ground surface \_\_\_\_\_ lbs. per sq. in. on \_\_\_\_\_  
(Date)


Water is controlled by \_\_\_\_\_  
(Cap, valve, etc.)





Township 16 S Range 4 W., W.M.

North

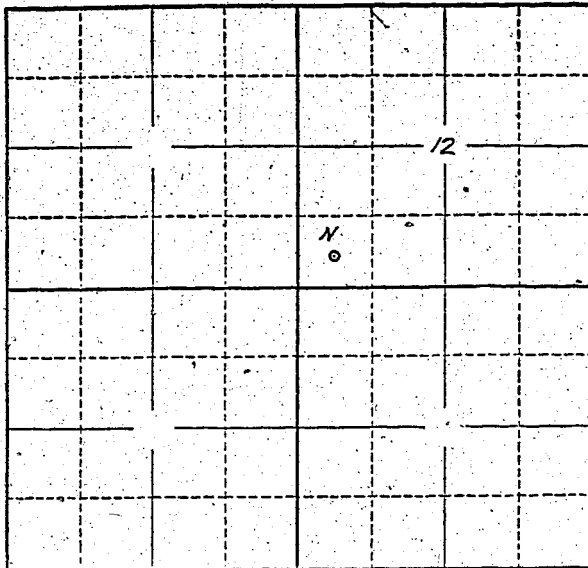

Locate well and acreage of irrigated land on plat.

Scale: 2" = 1 Mile

STATE OF OREGON

County of Linn } ss.

I, ~~Gerald W. and Marie Detering~~ <sup>Marie</sup> ~~Marie Detering~~, being first duly sworn, do hereby certify that I have read the foregoing Registration Statement and that all of the items therein contained are true to the best of my knowledge and belief.

Marie Detering & Gerald W. Detering  
(Signature of Registrant)

Subscribed and sworn to before me this 31st day of March, 1958

My commission expires October 4, 1961 Flora A. Lytle  
(Notary Public)

(SEAL)

CERTIFICATE OF REGISTRATION

STATE OF OREGON } ss.  
County of Marion

This is to certify that the foregoing Registration Statement was received in the office of the State Engineer on the 29th day of May, 1958, at 2.00 o'clock A. M. and has been duly recorded in said office in Book No: 7 of Registration Statements on page GR-1591

Witness my hand this 7th day of January, 1959  
Flora A. Stanley  
(State Engineer)

By \_\_\_\_\_ (Deputy)

\$15.00

GR-1591