

RECEIVED
MAY 20 1945
STATE ENGINEER
LINN, OREGON

Registration No. GR - 1629

Certificate No. GR - 1593

Registration Statement

OF CLAIMANT OF RIGHT TO APPROPRIATE GROUND WATER

TO THE STATE ENGINEER OF OREGON:

I, Gerald W. and Marie Detering

of Harrisburg County of Linn

State of Oregon, do hereby make application for a certificate of registration as evidence of a right to appropriate ground water.

1. Source from which water is withdrawn is Pump Well No. 1
(Flowing well, pump well, infiltration trench, or tunnel)

2. Location is: 6 miles south of Harrisburg, Oregon
(Approximate distance and direction from nearest city or town)

and is more particularly described as follows:

(a) 660' South and 580' E. of NW corn. of SW 1/4 of SE 1/4, S. 35, T. 15 S., R. 4 W.
(Give distance and bearing to corner of section or other legal subdivision)

being within SW 1/4 of SE 1/4 of Sec. 35, Twp. 15 S, Rge. 4 W
(Smallest legal subdivision) (N. or S.) (E. or W.)

or (b) within limits of recorded platted property, town or city:

in Lot _____, Block _____ of _____
(Name of plat or addition)

County of Linn
(If within city or town, give name)

3. Construction Work was begun on March 1945; was completed on March 1945
(Date) (Date)

and the ground water claimed was first used for the purposes set out below on May 1945
(Date)

since which time the water has been used continuously
(Continuously or intermittently)

from May 1945 to present time
(Date) (Date)

4. Quantity of water claimed and used is 500 gallons per minute; 114.0 acre feet per year.

5. Purpose or Purposes for which water is used Irrigation

(Domestic, irrigation, municipal, manufacturing, industrial, etc.)

6. Description of Well: Depth 30 feet. Type Driven
(Dug or drilled)

diameter 2 - 5 inches. Elevation of ground at well site 340 feet, mean sea level.
(As near as known)

Depth to water table 12 feet.

7. Capacity of Well: Not known g.p.m. with _____ feet drawdown.

_____ g.p.m. with _____ feet drawdown.


Date of test Not tested

If Flowing Well: Measured discharge _____ g.p.m. on _____
(Date)

Shut-in pressure at ground surface _____ lbs. per sq. in. on _____
(Date)

Water is controlled by _____
(Cap, valve, etc.)

Township 15 & 16 S Range 4 W, W.M.
North

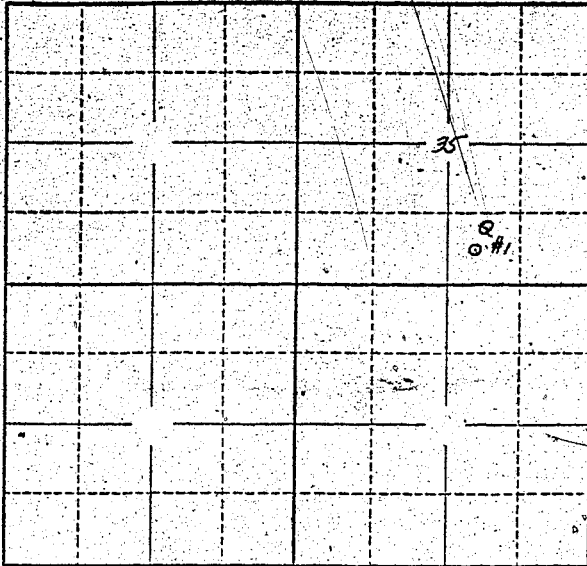

Locate well and acreage of irrigated land on plat.
Scale: 2" = 1 Mile

STATE OF OREGON

County of Linn } ss.

I, Gerald W. and Marie Detering, being first duly sworn, do hereby certify that I have read the foregoing Registration Statement and that all of the items therein contained are true to the best of my knowledge and belief.

Marie Detering

Gerald W. Detering
(Signature of Registrant)

Subscribed and sworn to before me this 31st day of March, 1958.

My commission expires October 7, 1961

Henry A. Tyler
(Notary Public)

(SEAL)

CERTIFICATE OF REGISTRATION

STATE OF OREGON

County of Marion } ss.

This is to certify that the foregoing Registration Statement was received in the office of the State Engineer on the 29th day of May, 1958, at 8:00 o'clock A. M. and has been duly recorded in said office in Book No. 7 of Registration Statements on page GR-1593

Witness my hand this 7th day of January, 1959

Henry A. Stanley
(State Engineer)

By _____ (Deputy)

#1920

GR-1593