

Registration Statement

OF CLAIMANT OF RIGHT TO APPROPRIATE GROUND WATER

TO THE STATE ENGINEER OF OREGON:

I, ALFRED DETTWYLER

of Rt. 2 Box 281 SILVERTON County of MARION

State of ORE. do hereby make application for a certificate of registration as evidence of a right to appropriate ground water.

1. Source from which water is withdrawn is WELL
(Flowing well, pump well, infiltration trench, or tunnel)

2. Location is: 5 MILES W SWEST OF SILVERTON, ORE.
(Approximate distance and direction from nearest city or town)

and is more particularly described as follows:

(a) 720 feet west & 660 feet North from S 1/4 corner Section 6,
(Give distance and bearing to corner of section or other legal subdivision)

being within SE 1/4 OF S.W. 1/4 of Sec. 6, Twp. 6 S, Rge. 1 W
(Smallest legal subdivision) (N. or S.) (E. or W.)

or (b) within limits of recorded platted property, town or city:

in Lot _____, Block _____ of _____
(Name of plat or addition)

County of MARION
(If within city or town, give name)

3. Construction Work was begun on AUG. 1950; was completed on AUG. 30, 1950
(Date) (Date)

and the ground water claimed was first used for the purposes set out below on AUG. 30, 1950
(Date)

since which time the water has been used Intermittently
(Continuously or Intermittently)

from AUG. 1950 to SEPT. 1957
(Date) (Date)

4. Quantity of water claimed and used is 175 gallons per minute; 70 acre feet per year.

5. Purpose or Purposes for which water is used = Irrigation

(Domestic, irrigation, municipal, manufacturing, industrial, etc.)

6. Description of Well: Depth 119 feet. Type Dug
(Dug or drilled)

diameter 10 inches. Elevation of ground at well site 150 feet, mean sea level.
(As near as known)

Depth to water table 40 feet.

7. Capacity of Well: 275 g.p.m. with 45 feet drawdown.

_____ g.p.m. with _____ feet drawdown.

Date of test JUG. 1950


If Flowing Well: Measured discharge 500 g.p.m. on _____
(Date)

Shut-in pressure at ground surface _____ lbs. per sq. in. on _____
(Date)

Water is controlled by _____
(Cap, valve, etc.)

Township 65 Range 1W, W.M.

North

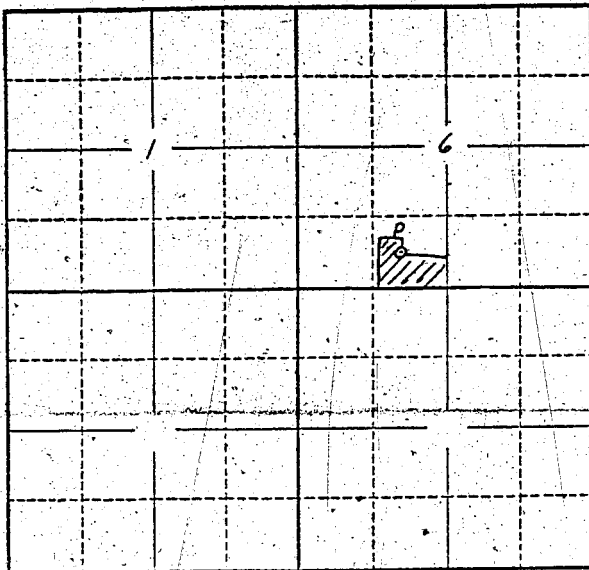

Locate well and acreage of irrigated land on plat.
Scale: 2" = 1 Mile

STATE OF OREGON

County of Marion

} ss.

I, _____, being first duly sworn, do hereby certify that I have read the foregoing Registration Statement and that all of the items therein contained are true to the best of my knowledge and belief.

Alfred D. Etnoyer
(Signature of Registrant)

Subscribed and sworn to before me this 20th day of February, 1958

My commission expires 12th June 1961

Wm. S. Bartholomew
(Notary Public)

(SEAL)

CERTIFICATE OF REGISTRATION

STATE OF OREGON

County of Marion

} ss.

This is to certify that the foregoing Registration Statement was received in the office of the State Engineer on the 2nd day of June, 1958, at 10⁰⁰ o'clock A.M. and has been duly recorded in said office in Book No. 7 of Registration Statements on page GR-1599

Witness my hand this 7th day of January

Leura A. Stanley
(State Engineer)

By _____

(Deputy)

#15.00

GR-1599