

Registration Statement

OF CLAIMANT OF RIGHT TO APPROPRIATE GROUND WATER

TO THE STATE ENGINEER OF OREGON:

I, Jacob H. Tompkins

of Route 1, Dayton County of Yamhill
(Mailing address)

State of Oregon, do hereby make application for a certificate of registration as evidence of a right to appropriate ground water.

1. Source from which water is withdrawn is flowing well
(Flowing well, pump well, infiltration trench, or tunnel)

2. Location is: 9 miles south & east of Dayton (Grand Island)
(Approximate distance and direction from nearest city or town)

and is more particularly described as follows:

(a) 1350' South, 2490' West of N. E. Corner, Sec. 22, Twp. 5 S., Range 3 W.
(Give distance and bearing to corner of section or other legal subdivision)

being within SW 1/4 of NE 1/4 of Sec. 22, Twp. 5 S., Rge. 3 W.
(Smallest legal subdivision) (N. or S.) (E. or W.)

or (b) within limits of recorded platted property, town or city:

in Lot _____; Block _____ of _____
(Name of plat or addition)
County of _____
(If within city or town, give name)

3. Construction Work was begun on July 1955; was completed on October 1955
(Date) (Date)

and the ground water claimed was first used for the purposes set out below on May 1956
(Date)

since which time the water has been used continuously
(Continuously or Intermittently)

from June 1956 to May 1958
(Date) (Date)

4. Quantity of water claimed and used is 500 gallons per minute; _____ acre feet per year.

5. Purpose or Purposes for which water is used irrigation
(Domestic, irrigation, municipal, manufacturing, industrial, etc.)

6. Description of Well: Depth 152 feet. Type drilled
(Dug or drilled)

diameter 10 & 6 inches. Elevation of ground at well site 110' feet, mean sea level.
(As near as known)

Depth to water table 0 feet.

7. Capacity of Well: 900 g.p.m. with 55' feet drawdown. (limit of pump)

_____ g.p.m. with _____ feet drawdown.

Date of test June 1957

If Flowing Well: Measured discharge 70 g.p.m. on June 1957
(Date)

Shut-in pressure at ground surface 35 lbs. per sq. in. on June 1957
(Date)

Water is controlled by cap & valve
(Cap, valve, etc.)

8. Casing: (Give diameter, commercial specifications and depth below ground surface of each casing size.)

10 inch diameter from 0 to 100 feet
 6 inch diameter from 90 to 159 feet
 inch diameter from to feet
 inch diameter from to feet

Describe and show depth of shoe, plug, adapter, liner or other details:

9. Perforated Casings or Screens:

5 per foot, one foot long of 30 from 140 to 150
(Number per foot and size of perforations, or describe screen)
 from to
 from to
 from to

10. Log of Well: (Describe each stratum or formation clearly, indicate if water bearing, and give thickness and depth as indicated.)

| MATERIAL | Thickness (Feet) | Depth to Bottom (Feet) |
|-----------------|------------------|------------------------|
| River Silt | 23 | 23 |
| Fine Gravel | 2 | 25 |
| Blue Clay | 70 | 95 |
| Black Quicksand | 3 | 98 |
| Blue Clay | 52 | 150 |
| Shale | 9 | 159 |
| | | |
| | | |
| | | |
| | | |
| | | |
| | | |
| | | |
| | | |
| | | |
| | | |
| | | |
| | | |
| | | |
| | | |

If log of well is not available, give name and address of driller.

11. Infiltration Trench: Covered or open

Dimensions: Length ft. Minimum depth ft. Maximum depth ft.

Bottom width ft. Discharge g.p.m. Date of test

12. Tunnel: Type of lining

Dimensions:
(Length, course, and cross sectional size)

Position of water bearing stratum with reference to portal of tunnel

Log of tunnel: (Preceding table for log of well may be used, if desired. Give footage from portal and character of materials, as pertinent.)

13. Pumping Equipment:

(a) Pump Berkley Shaft Deming Power Head Capacity 500 g.p.m.
(Make, type and size)


(b) Motor 7 1/2 HP 3 0 240 V motor
(Type and horsepower)

14. Location of area irrigated or to be irrigated, or place of use if for purposes other than irrigation.

| Township North or South | Range E. or W. of Willamette Meridian | Section | Forty-acre Tract | Number Acres To Be Irrigated | Date of Reclamation |
|----------------------------|--|---------|------------------|---------------------------------|------------------------|
| 5 S | 3 W | 22 | SW 1/4 of NE 1/4 | 35.0 | May 1956 |
| | | | | | |
| | | | | | |
15. If the ground water supply is supplemental to an existing water supply, identification of any application for a permit, permit, certificate or adjudicated right to appropriate water made or held by the registrant.

Township 5S Range 3W W.M.
North

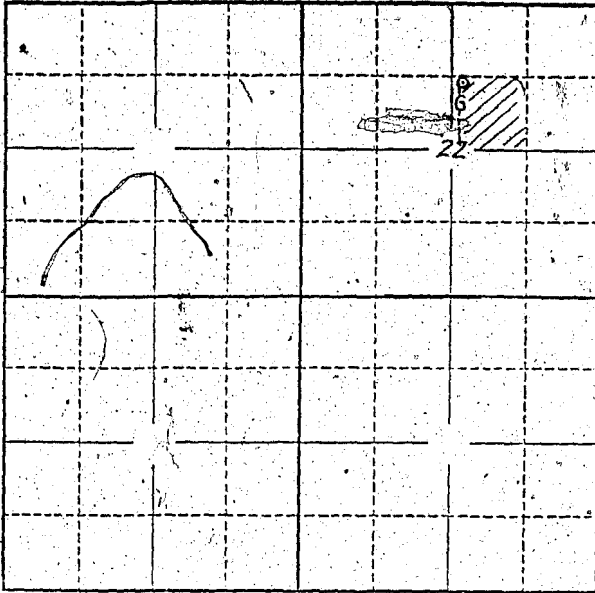

Locate well and acreage of irrigated land on plat.
Scale: 2" = 1 Mile

STATE OF OREGON

County of Marion

} ss.

I, Jacob H. Tompkins, being first duly sworn, do hereby certify that I have read the foregoing Registration Statement and that all of the items therein contained are true to the best of my knowledge and belief.

.....
(Signature of Registrant)

Subscribed and sworn to before me this 16 day of April, 19 58.

My commission expires Dec. 12, 1960

.....
(Notary Public)

(SEAL)

CERTIFICATE OF REGISTRATION

STATE OF OREGON

County of Marion

} ss.

This is to certify that the foregoing Registration Statement was received in the office of the State Engineer on the 3rd day of June, 19 58 at 9:00 o'clock A. M. and has been duly recorded in said office in Book No. 116 of Registration Statements on page GR 3797

Witness my hand this 20th day of November, 19 59

Laura A. Stanley
(State Engineer)

By.....
(Deputy)

GR 3797

#15.75