

860
RECEIVED
JUN 5 1958
STATE ENGINEER
SALEM, OREGON

REGISTRATION NO. GR-1652
CERTIFICATE NO. GR-1773

Registration Statement

OF CLAIMANT OF RIGHT TO APPROPRIATE GROUND WATER

(Under Chapter 708, Oregon Laws 1955.)

TO THE STATE ENGINEER OF OREGON:

I, R.M. Walker

of City of Independence County of Polk

State of Oregon, do hereby make application for a certificate of registration as evidence of a right to appropriate ground water.

1. Source from which water is withdrawn is Cooper Place Pump Well
(Flowing well, pump well, infiltration trench, or tunnel)

2. Location is: 1/2 mile S.E. of Independence
(Approximate distance and direction from nearest city or town)

and is more particularly described as follows:

(a) N 71° 14' W 785.0' from 1/4 Cor. S. Line Sec. 27
(Give distance and bearing to corner of section or other legal subdivision)

being within S.E. 1/4 S.W. 1/4 of Sec. 27, Twp. 8 S., Rge. 4 W.
(Smallest legal subdivision) (N. or S.) (E. or W.)

or (b) within limits of recorded platted property, town or city: _____

in Lot _____, Block _____ of _____
(Name of plat or addition)

(If within city or town, give name) County of Marian

3. Construction Work was begun on June 9, 1947 was completed on June 12, 1947
(Date) (Date)

and the ground water claimed was first used for the purposes set out below on June 15, 1947
(Date)

since which time the water has been used _____
(Continuously or Intermittently)

from June 15, 1948 to Sept. 4, 1948
(Date) (Date)

4. Quantity of water claimed and used is 780 gallons per minute; _____ acre feet per year.

5. Purpose or Purposes for which water is used Irrigation of Farm Crops
(Domestic, irrigation, municipal, manufacturing, industrial, etc.)

6. Description of Well: Depth _____ feet. Type drilled
(Dug or drilled)

diameter 12" inches. Elevation of ground at well site 155 feet, mean sea level.
(As near as known)

Depth to water table 1.5 feet.

7. Capacity of Well: _____ g.p.m. with _____ feet drawdown.

_____ g.p.m. with _____ feet drawdown.

Date of test _____

If Flowing Well: Measured discharge _____ g.p.m. on _____
(Date)

Shut-in pressure at ground surface _____ lbs. per sq. in. on _____
(Date)

Water is controlled by _____
(Cap. valve, etc.)

If log of well is not available, give name and address of driller.

11. Infiltration Trench: Covered or open

Dimensions: Length _____ ft. Minimum depth _____ ft. Maximum depth _____ ft.

Bottom width _____ ft. Discharge _____ g.p.m. Date of test _____

12. Tunnel: Type of lining

Dimensions: _____
(Length, course, and cross sectional size)

Position of water bearing stratum with reference to portal of tunnel _____

Log of tunnel: (Preceding table for log of well may be used, if desired. Give footage from portal and character of materials, as pertinent.)

13. Pumping Equipment:

(a) Pump DeLaval Centrifugal K 6/5 Capacity 750 @ 200 ft. Head 1 g.p.m.
(Make, type and size)


(b) Motor GE Induction Motor 60 H.P. Type KT. 60 cycle, 1740 R.P.M.
(Type and horsepower)

14. Location of area irrigated or to be irrigated, or place of use if for purposes other than irrigation.

Township North or South	Range E. or W. of Willamette Meridian	Section	Forty-acre Tract	Number Acres To Be Irrigated	Date of Reclamation
8 S	4 W	27	S.E. 1/4 S.W. 1/4	25.74	1958
8 S	4 W	27	N.E. 1/4 S.W. 1/4	12.10	"
8 S	4 W	34	N.E. 1/4 N.W. 1/4	15.45	"
				53.29	
				about 65	June 15, 1952 on this well. on former well on this ground about 1948.

15. If the ground water supply is supplemental to an existing water supply, identification of any application for a permit, permit, certificate or adjudicated right to appropriate water made or held by the registrant.

Township 8 S Range 4 W, W.M.
North

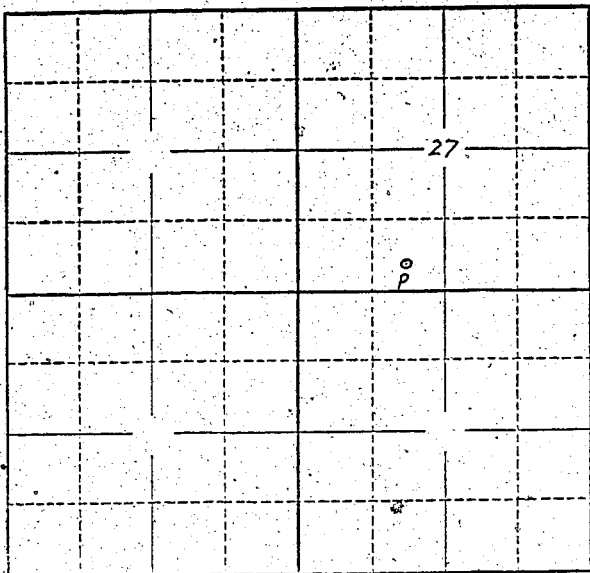

Locate well and acreage of irrigated land on plat.
Scale: 2" = 1 Mile

STATE OF OREGON

County of Marion } ss.

I, R. W. Walker being first duly sworn, do hereby certify that I have read the foregoing Registration Statement and that all of the items therein contained are true to the best of my knowledge and belief.

R. W. Walker
(Signature of Registrant)

Subscribed and sworn to before me this 3 day of June, 1958

My commission expires 2-27-58

Ronald T. Beatty
(Notary Public)

(SEAL)

CERTIFICATE OF REGISTRATION

STATE OF OREGON

County of Marion } ss.

This is to certify that the foregoing Registration Statement was received in the office of the State Engineer on the 3rd day of June, 1958, at 9:00 o'clock P.M. and has been duly recorded in said office in Book No. B of Registration Statements on page GR-1773

~~Construction shall be completed by _____, 19____ and the water completely applied to beneficial use by _____, 19____.~~

Witness my hand this 7th day of January, 1959

Laura A. Stanley
(State Engineer)

#18.60

By _____ (Deputy)

GR-1773