

RECEIVED

REGISTRATION NO. GR-1653  
CERTIFICATE NO. GR-1767

Registration Statement

JUL 13 1958  
STATE ENGINEER  
SALEM, OREGON

CLAIMANT OF RIGHT TO APPROPRIATE GROUND WATER

(Under Chapter 708, Oregon Laws 1955.)

TO THE STATE ENGINEER OF OREGON:

I, Oregon Hop Co.

of \_\_\_\_\_ County of \_\_\_\_\_

State of Oregon, do hereby make application for a certificate of registration as evidence of a right to appropriate ground water.

1. Source from which water is withdrawn is #1 Oregon Hop Co. Pump Well  
(Flowing well, pump well, infiltration trench, or tunnel)

2. Location is: 1/4 Mile East of Independence  
(Approximate distance and direction from nearest city or town)

and is more particularly described as follows:

(a) N 3° 16' W 857.5' from W Cor. E Line Sec. 28  
(Give distance and bearing to corner of section or other legal subdivision)

being within S.E. 1/4 N.E. 1/4 of Sec. 28, Twp. 8 S, Rge. 7 W  
(Smallest legal subdivision) (N. or S.) (E. or W.)

or (b) within limits of recorded platted property, town or city: \_\_\_\_\_

in Lot \_\_\_\_\_, Block \_\_\_\_\_ of \_\_\_\_\_  
(Name of plat or addition)

County of Marion  
(If within city or town, give name)

3. Construction Work was begun on April 1, 1947; was completed on April 1947  
(Date) (Date)

and the ground water claimed was first used for the purposes set out below on April 1947  
(Date)

since which time the water has been used Continuously or Intermittently

This year  
from May 1, 1938 to Aug 20, 1938  
(Date) (Date)

4. Quantity of water claimed and used is 6,007.800 gallons per minute; \_\_\_\_\_ acre feet per year.

5. Purpose or Purposes for which water is used Irrigation of farm crops  
(Domestic, irrigation, municipal, manufacturing, industrial, etc.)

6. Description of Well: Depth 37 feet. Type drilled  
(Dug or drilled)

diameter 12" inches. Elevation of ground at well site 15.5 feet, mean sea level.  
(As near as known)

Depth to water table 10 feet.

7. Capacity of Well: \_\_\_\_\_ g.p.m. with \_\_\_\_\_ feet drawdown.

\_\_\_\_\_ g.p.m. with \_\_\_\_\_ feet drawdown.

Date of test \_\_\_\_\_

If Flowing Well: Measured discharge \_\_\_\_\_ g.p.m. on \_\_\_\_\_  
(Date)


Shut-in pressure at ground surface \_\_\_\_\_ lbs. per sq. in. on \_\_\_\_\_  
(Date)

Water is controlled by \_\_\_\_\_  
(Cap, valve, etc.)





Township 8 S. Range 4 W., W.M.  
North

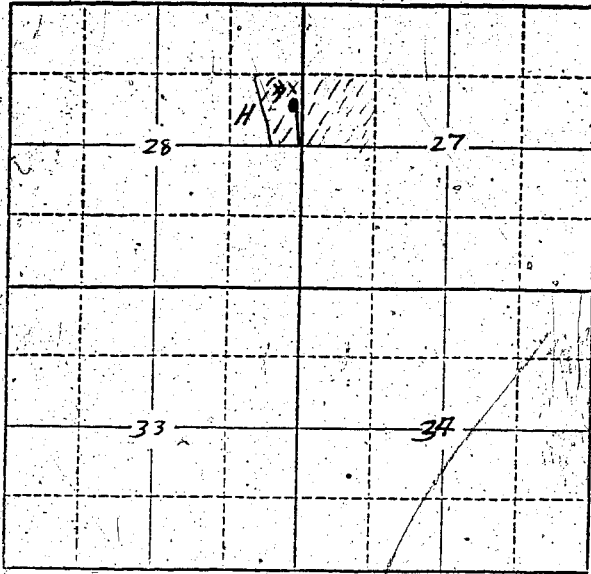

Locate well and acreage of irrigated land on plat.  
Scale: 2" = 1 Mile

STATE OF OREGON

County of Marion } ss.

I, Gregory H. R. Miller, Inc., being first duly sworn, do hereby certify that I have read the foregoing Registration Statement and that all of the items therein contained are true to the best of my knowledge and belief.

Gregory H. R. Miller, Inc.  
by R. M. Miller, Pres.  
(Signature of Registrant)

Subscribed and sworn to before me this 3 day of June, 1958.

My commission expires 2-27-62

Edward J. Brantley  
(Notary Public)

(SEAL)

CERTIFICATE OF REGISTRATION

STATE OF OREGON } ss.  
County of Marion

This is to certify that the foregoing Registration Statement was received in the office of the State Engineer on the 3rd day of June, 1958, at 4:00 o'clock P.M. and has been duly recorded in said office in Book No. B of Registration Statements on page GR-1767.

~~Construction shall be completed by 1959, and the water completely applied to beneficial use by 1959.~~

Witness my hand this 7th day of January, 1959.

Lewis A. Stanley  
(State Engineer)

\$19.80

By \_\_\_\_\_ (Deputy)

GR-1767