

RECEIVED

Registration Statement

REGISTRATION NO. GR-1654
CERTIFICATE NO. GR-1768

JUN 8 1958
STATE ENGINEER
SALEM, OREGON

OF CLAIMANT OF RIGHT TO APPROPRIATE GROUND WATER

(Under Chapter 768, Oregon Laws 1955.)

TO THE STATE ENGINEER OF OREGON:

I, Oregon Hop Co.

of _____ County of _____

State of Oregon, do hereby make application for a certificate of registration as evidence of a right to appropriate ground water.

- 1. Source from which water is withdrawn is Pump Well # 2
(Flowing well, pump well, infiltration trench, or tunnel)
- 2. Location is: 1/4 Mile East of Independence
(Approximate distance and direction from nearest city or town)

and is more particularly described as follows:

(a) N31°38'E 2568.2' from 1/4 Cor. W. line Sec. 27
(Give distance and bearing to corner of section or other legal subdivision)

being within N.W. 1/4 N.W. 1/4 of Sec. 27, Twp. 8 S, Rge. 4 E
(Smallest legal subdivision) (N. or S.) (E. or W.)

or (b) within limits of recorded platted property, town or city: _____

in Lot _____, Block _____ of _____
(Name of plat or addition)

County of Marion
(If within city or town, give name)

3. Construction Work was begun on Spring 1947; was completed on Spring 1947
(Date) (Date)

and the ground water claimed was first used for the purposes set out below on May 1947
(Date)

since which time the water has been used _____
(Continuously or intermittently)
about from May to Sept each yr
(Date) (Date)

4. Quantity of water claimed and used is 1100 gallons per minute; _____ acre feet per year.

5. Purpose or Purposes for which water is used Irrigation of farm crops
(Domestic, irrigation, municipal, manufacturing, industrial, etc.)

6. Description of Well: Depth 28 feet. Type drilled
(Dug or drilled)
diameter 12 inches. Elevation of ground at well site 155 feet, mean sea level,
(As near as known)
Depth to water table 12 feet.

7. Capacity of Well: _____ g.p.m. with _____ feet drawdown.
_____ g.p.m. with _____ feet drawdown.


Date of test _____

If Flowing Well: Measured discharge _____ g.p.m. on _____
(Date)

Shut-in pressure at ground surface _____ lbs. per sq. in. on _____
(Date)

Water is controlled by _____
(Cap, valve, etc.)

Township 8 S Range 4 W W.M.
North

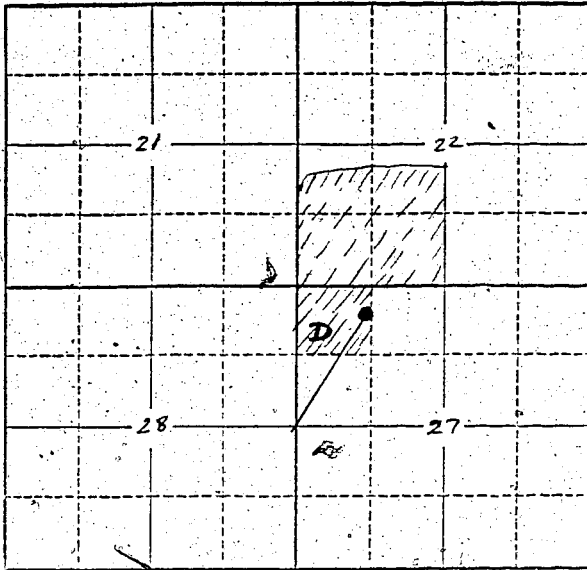

Locate well and acreage of irrigated land on plat.
Scale: 2" = 1 Mile

STATE OF OREGON

County of Marion

ss.

I, Donald Stephen R. Miller, Sr., being first duly sworn, do hereby certify that I have read the foregoing Registration Statement and that all of the items therein contained are true to the best of my knowledge and belief.

Donald Stephen R. Miller, Sr.
(Signature of Registrant)

Subscribed and sworn to before me this 3 day of June, 1958

My commission expires 2-27-62

Donald Z. [unclear]
(Notary Public)

(SEAL)

CERTIFICATE OF REGISTRATION

STATE OF OREGON

County of Marion

ss.

This is to certify that the foregoing Registration Statement was received in the office of the State Engineer on the 3rd day of June, 1958, at 4:20 o'clock P.M. and has been duly recorded in said office in Book No. 8 of Registration Statements on page GR-1768

~~Construction shall be completed by 1959 and the water completely applied to beneficial use by 1959.~~

Witness my hand this 7th day of January, 1959

Lewin A. Standen
(State Engineer)

\$ 29.20

By _____ (Deputy)

GR-1768