

Registration Statement CERTIFICATE NO. GR-1769

RECEIVED

CLAIMANT OF RIGHT TO APPROPRIATE GROUND WATER

(Under Chapter 708, Oregon Laws 1955.)

JUL 3 1956  
STATE ENGINEER  
SALEM, OREGON

TO THE STATE ENGINEER OF OREGON:

I, Oregon Hop Co

of \_\_\_\_\_ County of \_\_\_\_\_

State of Oregon, do hereby make application for a certificate of registration as evidence of a right to appropriate ground water.

1. Source from which water is withdrawn is Pump Well #3 Oregon Hop Co.  
(Flowing well, pump well, infiltration trench, or tunnel)

2. Location is: 1/4 Mile East of Independence  
(Approximate distance and direction from nearest city or town)

and is more particularly described as follows:

(a) N 39° 16' W 857.5', N 13° 50' W 1344' & N 30° 56' W of 1/4 Cor. E Line Sec. 28  
(Give distance and bearing to corner of section or other legal subdivision)

being within N.E. 1/4 N.E. 1/4 of Sec. 28, Twp. S. 5, Rge. 4W  
(Smallest legal subdivision) (N. or S.) (E. or W.)

or (b) within limits of recorded platted property, town or city: \_\_\_\_\_

in Lot \_\_\_\_\_, Block \_\_\_\_\_ of \_\_\_\_\_  
(Name of plat or addition)

County of Marion  
(If within city or town, give name)

3. Construction Work was begun on HAUNT SPRING 1942; was completed on Spring 1942  
(Date) (Date)

and the ground water claimed was first used for the purposes set out below on 1942 to 1946 used on a gravel plant. 1946 to 1958 Farm crops  
(Date)

since which time the water has been used \_\_\_\_\_  
(Continuously or intermittently)

from MAY to SEPT  
(Date) (Date)

4. Quantity of water claimed and used is 800 gallons per minute; \_\_\_\_\_ acre feet per year.

5. Purpose or Purposes for which water is used: IRRIGATION OF FARM CROPS  
(Domestic, irrigation, municipal, manufacturing, industrial, etc.)

6. Description of Well: Depth 36' feet. Type drilled  
(Dug or drilled)

diameter 12 inches. Elevation of ground at well site 155 feet, mean sea level.  
(As near as known)

Depth to water table 15 feet.

7. Capacity of Well: \_\_\_\_\_ g.p.m. with \_\_\_\_\_ feet drawdown.

\_\_\_\_\_ g.p.m. with \_\_\_\_\_ feet drawdown.

Date of test \_\_\_\_\_

If Flowing Well: Measured discharge \_\_\_\_\_ g.p.m. on \_\_\_\_\_  
(Date)

Shut-in pressure at ground surface \_\_\_\_\_ lbs. per sq. in. on \_\_\_\_\_  
(Date)

Water is controlled by \_\_\_\_\_  
(Cap, valve, etc.)



If log of well is not available, give name and address of driller.

11. Infiltration Trench: Covered or open \_\_\_\_\_  
 Dimensions: Length \_\_\_\_\_ ft. Minimum depth \_\_\_\_\_ ft. Maximum depth \_\_\_\_\_ ft.  
 Bottom width \_\_\_\_\_ ft. Discharge \_\_\_\_\_ g.p.m. Date of test \_\_\_\_\_

12. Tunnel: Type of lining \_\_\_\_\_  
 Dimensions: \_\_\_\_\_  
(Length, course, and cross sectional size)  
 Position of water bearing stratum with reference to portal of tunnel \_\_\_\_\_

Log of tunnel: (Preceding table for log of well may be used, if desired. Give footage from portal and character of materials, as pertinent.)


13. Pumping Equipment:  
 (a) Pump Fairbanks-Morse 5/4 Split Case Capacity 800 g.p.m.  
(Make, type and size)  
 (b) Motor F.M. 50 HP 1750 R.P.M.  
(Type and horsepower)

14. Location of area irrigated or to be irrigated, or place of use if for purposes other than irrigation.

Township North or South	Range E. or W. of Willamette Meridian	Section	Forty-acre Tract	Number Acres To Be Irrigated	Date of Reclamation
<u>85R</u>	<u>4W</u>	<u>28</u>	<u>N.E. 1/4 N.E. 1/4</u>	<u>29.8</u>	<u>1946</u>
<u>85</u>	<u>4W</u>	<u>21</u>	<u>S.E. 1/4 S.E. 1/4</u>	<u>20.7</u>	<u>"</u>
<u>85</u>	<u>4W</u>	<u>21</u>	<u>N.E. 1/4 S.E. 1/4</u>	<u>2.5</u>	<u>Gravel Plant</u>
				<u>53.00</u>	<u>SPRING</u>
					<u>1942 to 1946</u>
					<u>1946 to 1958</u>
					<u>Farm crops</u>

15. If the ground water supply is supplemental to an existing water supply, identification of any application for a permit, permit, certificate or adjudicated right to appropriate water made or held by the registrant.

Township 8.5 Range 4W W.M.  
North

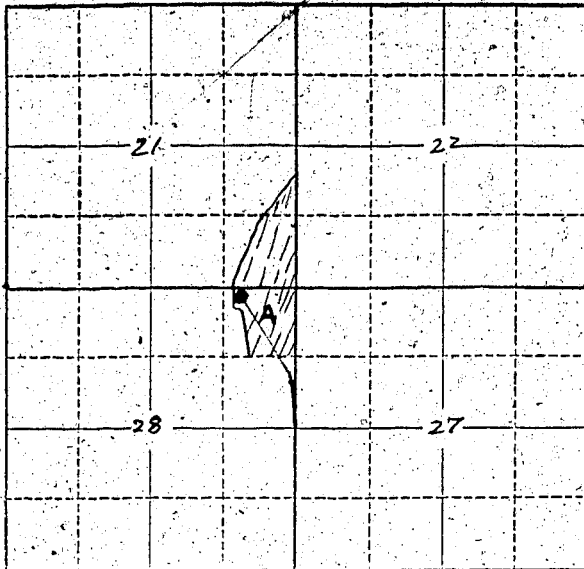

Locate well and acreage of irrigated land on plat.  
Scale: 2" = 1 Mile

STATE OF OREGON

County of MARION

ss.

I, OREGON HOP CO. R.M. WALKER, JR. being first duly sworn, do hereby certify that I have read the foregoing Registration Statement and that all of the items therein contained are true to the best of my knowledge and belief.

*Walter H. Walker*  
*W/1777 Walker*  
*Per*

(Signature of Registrant)

Subscribed and sworn to before me this 3 day of JUNE, 1958

My commission expires 2-27-62

*Donald L. Bostwright*  
(Notary Public)

(SEAL)

CERTIFICATE OF REGISTRATION

STATE OF OREGON

County of Marion

ss.

This is to certify that the foregoing Registration Statement was received in the office of the State Engineer on the 3rd day of June, 1958 at 4:20 o'clock P.M. and has been duly recorded in said office in Book No. 8 of Registration Statements on page GR-1769

~~Construction shall be completed by \_\_\_\_\_ and the water completely applied for beneficial use by \_\_\_\_\_ 19\_\_\_\_.~~

Witness my hand this 7th day of January, 1959

*Laura A. Stanley*  
(State Engineer)

*7/8/55*

By \_\_\_\_\_ (Deputy)

GR-1769