

RECEIVED
MAY 11 1950
STATE ENGINEER
SALEM OREGON

Registration No. GR 1662
Certificate No. GR 1613

Registration Statement

OF CLAIMANT OF RIGHT TO APPROPRIATE GROUND WATER

TO THE STATE ENGINEER OF OREGON:

I, J. P. Grizzel

of Rt. 2, Box 361, Albany County of Linn
(Mailing address)

State of Oregon, do hereby make application for a certificate of registration as evidence of a right to appropriate ground water.

1. Source from which water is withdrawn is Pump well No. 1
(Flowing well, pump well, infiltration trench, or tunnel)

2. Location is: 9 miles North of Albany, Oregon
(Approximate distance and direction from nearest city or town)

and is more particularly described as follows:

(a) S. 48°20' W. 22.5 Chains from NE corner S. 5, T 10 S., R. 3 W.
(Give distance and bearing to corner of section or other legal subdivision)

being within NE¹ of NE¹ of Sec. 5, Twp. 10 S, Rge. 3 W.
(Smallest legal subdivision) (N. or S.) (E. or W.)

or (b) within limits of recorded platted property, town or city:

in Lot _____, Block _____ of _____
(Name of plat or addition)

County of Linn
(If within city or town, give name)

3. Construction Work was begun on 1950; was completed on 1950
(Date) (Date)

and the ground water claimed was first used for the purposes set out below on 1950
(Date)

since which time the water has been used Continuously
(Continuously or Intermittently)

from 1950 to present time
(Date) (Date)

4. Quantity of water claimed and used is 350 gallons per minute; 43.5 acre feet per year.

5. Purpose or Purposes for which water is used Irrigation
(Domestic, irrigation, municipal, manufacturing, industrial, etc.)

6. Description of Well: Depth 26 feet. Type driven
(Dug or drilled)

diameter 4 inches. Elevation of ground at well site 190 feet, mean sea level.
(As near as known)

Depth to water table 8 feet.

7. Capacity of Well: _____ g.p.m. with _____ feet drawdown.

_____ g.p.m. with _____ feet drawdown.

Date of test Not tested

If Flowing Well: Measured discharge _____ g.p.m. on _____
(Date)

Shut-in pressure at ground surface _____ lbs. per sq. in. on _____
(Date)

Water is controlled by _____
(Cap, valve, etc.)

If log of well is not available, give name and address of driller. Jaaper Turnidge and Lynn Hoefler,
Albany, Oregon

11. Infiltration Trench: Covered or open _____

Dimensions: Length _____ ft. Minimum depth _____ ft. Maximum depth _____ ft.

Bottom width _____ ft. Discharge _____ g.p.m. Date of test _____

12. Tunnel: Type of lining _____

Dimensions: _____
(Length, course, and cross sectional size)

Position of water bearing stratum with reference to portal of tunnel _____

Log of tunnel: (Preceding table for log of well may be used, if desired. Give footage from portal and character of materials, as pertinent.)

13. Pumping Equipment:

(a) Pump Allis Chalmers 3" Centrifugal Capacity 350 g.p.m.
(Make, type and size)

(b) Motor 15 H.P. Electric
(Type and horsepower)

14. Location of area irrigated or to be irrigated, or place of use if for purposes other than irrigation.


Township North or South	Range E. or W. of Willamette Meridian	Section	Forty-acre Tract	Number Acres To Be Irrigated	Date of Reclamation
10 S	3 W	5	NE $\frac{1}{4}$ of NE $\frac{1}{4}$	14.2	1950
10 S	3 W	5	SE $\frac{1}{4}$ of NE $\frac{1}{4}$	3.2	1950
				17.4	

239-744 Grizzel

Tract I: Lots 3 & 4, Section 32, T. 9 S., R. 3 W. of the will. Mer. in Linn County, Oregon.
Tract II: Beginning at a point which is S.42'W. 20 chains and West 9.95 chains from the Northeast corner of the Southeast quarter of Section 5, T. 10 S., R. 3 W. of the will. Mer. in Linn County, Oregon; thence West 4.20 chains; thence North 8.25 chains; thence West 3.00 chains; thence North 54.57 chains to a point which is N.89°42'W. 7.25 chains distant from the Northwest corner of the Northeast quarter of the Northeast quarter of the Northeast quarter of said Section 5, thence S.89°42'E. 7.25 chains; thence South 62.82 chains to the place of beginning; SUBJECT of the rights of the public in road.

15. If the ground water supply is supplemental to an existing water supply, identification of any application for a permit, permit, certificate or adjudicated right to appropriate water made or held by the registrant.

Township 10 S Range 3 W W.M.
North

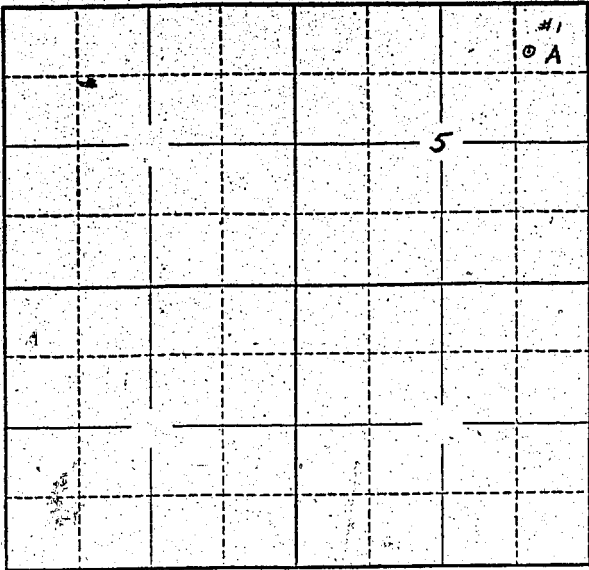

Locate well and acreage of irrigated land on plat.
Scale: 2" = 1 Mile

STATE OF OREGON }
County of Linn } ss.

I, J. P. Grizzel, being first duly sworn, do hereby certify that I have read the foregoing Registration Statement and that all of the items therein contained are true to the best of my knowledge and belief.

J. P. Grizzel
(Signature of Registrant)

Subscribed and sworn to before me this 5th day of June, 1958

My commission expires 11-16-59
Janet C. Blake
(Notary Public)

(SEAL)

CERTIFICATE OF REGISTRATION

STATE OF OREGON }
County of Marion } ss.

This is to certify that the foregoing Registration Statement was received in the office of the State Engineer on the 5th day of June, 1958, at 8:00 o'clock A.M. and has been duly recorded in said office in Book No. 8 of Registration Statements on page GR-1613

Witness my hand this 7th day of January, 1958
Clara A. Stanley
(State Engineer)

By _____
(Deputy)

GR - **1613**

\$15.00