

RECEIVED
JUN 10 1958
STATE ENGINEER
SALEM, OREGON

Registration No. GR 1664
Certificate No. GR 1615

Registration Statement

OF CLAIMANT OF RIGHT TO APPROPRIATE GROUND WATER

TO THE STATE ENGINEER OF OREGON:

I, Marvin E. Glaser

of Rt. 1, Box 332, Albany County of Linn
(Mailing address)

State of Oregon, do hereby make application for a certificate of registration as evidence of a right to appropriate ground water.

1. Source from which water is withdrawn is pump well
(Flowing well, pump well, infiltration trench, or tunnel)

2. Location is: 7 1/2 SE of Albany, Oregon
(Approximate distance and direction from nearest city or town)

and is more particularly described as follows:

(a) 2838 feet south and 2772 feet west of NE corner of S. 18, T. 11 S., R. 2 W.
(Give distance and bearing to corner of section or other legal subdivision)
being within NE 1/4 of SW 1/4 of Sec. 18, Twp. 11 S., Rge. 2 W.
(Smallest legal subdivision) (N. or S.) (E. or W.)

or (b) within limits of recorded platted property, town or city:
in Lot _____, Block _____ of _____
(Name of plat or addition)

County of Linn
(If within city or town, give name)

3. Construction Work was begun on Dec. 1952; was completed on Dec. 1952
(Date) (Date)

and the ground water claimed was first used for the purposes set out below on May 1953
(Date)

since which time the water has been used continuously
(Continuously or intermittently)

from May 1953 to present time
(Date) (Date)

4. Quantity of water claimed and used is 255 gallons per minute; 95.0 acre feet per year.

5. Purpose or Purposes for which water is used Irrigation

(Domestic, irrigation, municipal, manufacturing, industrial, etc.)

6. Description of Well: Depth 105 feet. Type Drilled
(Dug or drilled)

diameter 8 inches. Elevation of ground at well site 300 feet, mean sea level.
(As near as known)

Depth to water table 15 feet.

7. Capacity of Well: 260 g.p.m. with 55 feet drawdown.
_____ g.p.m. with _____ feet drawdown.


Date of test 1953

If Flowing Well: Measured discharge _____ g.p.m. on _____
(Date)

Shut-in pressure at ground surface _____ lbs. per sq. in. on _____
(Date)

Water is controlled by _____
(Cap. valve, etc.)

Township 11 S Range 2 W, W.M.
North

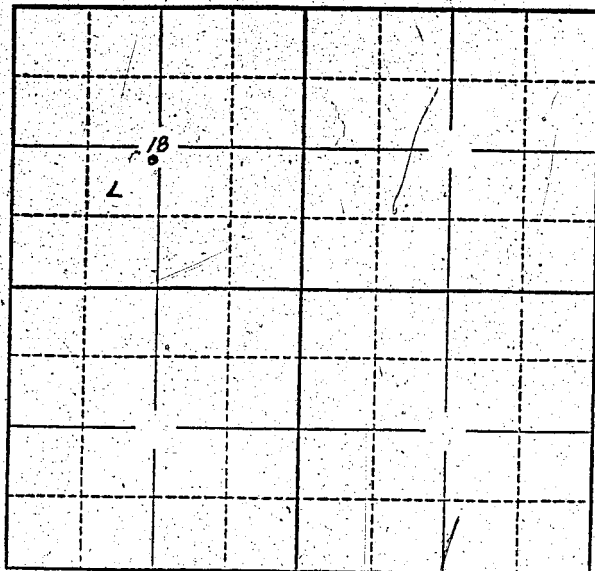

Locate well and acreage of irrigated land on plat.
Scale: 2" = 1 Mile

STATE OF OREGON

County of Linn } ss.

I, Marvin E. Glaser, being first duly sworn, do hereby certify that I have read the foregoing Registration Statement and that all of the items therein contained are true to the best of my knowledge and belief.

Marvin E. Glaser
(Signature of Registrant)

Subscribed and sworn to before me this 28th day of May, 1958.

My commission expires Feb. 19, 1960.

Dorothy M. Blacketer
(Notary Public)
Notary Public for Oregon

(SEAL)

CERTIFICATE OF REGISTRATION

STATE OF OREGON } ss.
County of Marion

This is to certify that the foregoing Registration Statement was received in the office of the State Engineer on the 5th day of June, 1959, at 8:00 o'clock A. M. and has been duly recorded in said office in Book No. 8 of Registration Statements on page GR-1615

Witness my hand this 7th day of January, 1959.

Henry G. Stanley
(State Engineer)

By _____ (Deputy)

GR-1615

\$16.20