

**Registration Statement****OF CLAIMANT OF RIGHT TO APPROPRIATE GROUND WATER**

TO THE STATE ENGINEER OF OREGON:

I, Richard and Erna Cushingof Rt. 1, Box 455, Albany

(Mailing address)

County of LinnState of Oregon

do hereby make application for a certificate of registration as evidence of a right to appropriate ground water.

1. Source from which water is withdrawn is pump well

(Flowing well, pump well, infiltration trench, or tunnel)

2. Location is: 2 miles southwest of Albany, Oregon

(Approximate distance and direction from nearest city or town)

and is more particularly described as follows:

(a) N. 24° 15' W. 11.5 chains from SE corner DIC 50

(Give distance and bearing to corner of section or other legal subdivision)

being within

NE<sup>1</sup> of NE<sup>1</sup>

(Smallest legal subdivision)

of Sec. 17,Twp. 11 S,Rge. 3 W

(N. or S.)

(E. or W.)

or

(b) within limits of recorded platted property, town or city:

in Lot \_\_\_\_\_,

Block \_\_\_\_\_

of \_\_\_\_\_

(Name of plat or addition)

County of Linn

(If within city or town, give name)

3. Construction Work was begun on June 11, 1951

(Date)

; was completed on June 20, 1951

(Date)

and the ground water claimed was first used for the purposes set out below on July 12, 1951

(Date)

since which time the water has been used continuously

(Continuously or intermittently)

from July 12, 1951 to present time

(Date)

(Date)

4. Quantity of water claimed and used is 80 gallons per minute; 33.5 acre feet per year.5. Purpose or Purposes for which water is used Irrigation

(Domestic, irrigation, municipal, manufacturing, industrial, etc.)

6. Description of Well: Depth 84 feet. Type Drilled

(Dug or drilled)

diameter 6 inches.

Elevation of ground at well site

225

feet, mean sea level.

(As near as known)

Depth to water table 16 feet.7. Capacity of Well: 120 g.p.m. with 60 feet drawdown.

\_\_\_\_\_ g.p.m. with \_\_\_\_\_ feet drawdown.

Date of test July 12, 1951

If Flowing Well: Measured discharge \_\_\_\_\_ g.p.m. on \_\_\_\_\_

(Date)

Shut-in pressure at ground surface \_\_\_\_\_ lbs. per sq. in. on \_\_\_\_\_

(Date)

Water is controlled by \_\_\_\_\_

(Cap, valve, etc.)

**8. Casing:** (Give diameter, commercial specifications and depth below ground surface of each casing size.)

6 inch diameter steel casing from 0 to 84 feet  
 inch diameter from to feet  
 inch diameter from to feet  
 inch diameter from to feet

Describe and show depth of shoe, plug, adapter, liner or other details:

.....

.....

**9. Perforated Casings or Screens:**

Slot perforations from 64 to 84  
(Number per foot and size of perforations, or describe screen)  
 from to  
 from to  
 from to

**10. Log of Well:** (Describe each stratum or formation clearly, indicate if water bearing, and give thickness and depth as indicated.)

MATERIAL	Thickness (Feet)	Depth to Bottom (Feet)
Not available		

If log of well is not available, give name and address of driller. Cy Burkhart, Tremonton, Utah

11. Infiltration Trench: Covered or open \_\_\_\_\_

Dimensions: Length \_\_\_\_\_ ft. Minimum depth \_\_\_\_\_ ft. Maximum depth \_\_\_\_\_ ft.  
 Bottom width \_\_\_\_\_ ft. Discharge \_\_\_\_\_ g.p.m. Date of test \_\_\_\_\_

12. Tunnel: Type of lining \_\_\_\_\_

Dimensions: \_\_\_\_\_  
(Length, course, and cross sectional size)  
 Position of water bearing stratum with reference to portal of tunnel \_\_\_\_\_

Log of tunnel: (Preceding table for log of well may be used, if desired. Give footage from portal and character of materials, as pertinent.)

13. Pumping Equipment:

(a) Pump Fairbanks Morse Deep Well Turbine Capacity 80 g.p.m.  
(Make, type and size)  
 (b) Motor 5 H. P. electric  
(Type and horsepower)

14. Location of area irrigated or to be irrigated, or place of use if for purposes other than irrigation.


Township North or South	Range E. or W. of Willamette Meridian	Section	Forty-acre Tract	Number Acres To Be Irrigated	Date of Reclamation
11 S	3 W	8	SE $\frac{1}{4}$ of SE $\frac{1}{4}$	1.4	July 12, 1951
11 S	3 W	8	SW $\frac{1}{4}$ of SE $\frac{1}{4}$	4.9	" "
11 S	3 W	17	NW $\frac{1}{4}$ of NE $\frac{1}{4}$	5.5	" "
11 S	3 W	17	NE $\frac{1}{4}$ of NE $\frac{1}{4}$	1.6	" "
				13.4	

173-211

Beginning at a point on the East boundary line of the D.L.C. of Leander C. Burkhart and wife, Not. No. 702, and Claim 50 in T. 11 S., R. 3 W. of the Will. Mer. in Linn County, Oregon, which is N.1°35'W. 24.00 chains distant from the Southeast corner of said Claim, and running thence N.1°3'W. along the East boundary line of said Claim; 7.97 chains; thence S. 24.72 chains; thence S.2°3'E. 7.97 chains to the Northwest corner of land owned to R. L. Burkhart in deed records on Page 515, Vol. 70, Deed records of Linn County, Oregon; thence East to the place of beginning, Excepting the following: Beginning at a point on the East boundary line of Leander C. Burkhart D.L.C. 50 in T. 11 S., R. 3 W. of the Will. Mer. in Linn County, Oregon, which is N.1°35'W. 5.38 chains from the South at corner of said Claim 50; and running thence N.1°33'W. along the East boundary line of said Claim 2.44 chains; thence West 24.60 chains to the west line of the property formerly owned by Eva Irene Maxwell and Wm. D. Maxwell, her husband; thence S.2°3'W. 2.44 chains to the Southwest corner of the property formerly owned by Eva Irene Maxwell and Wm. D. Maxwell, her husband; thence East 24.04 chains to the place of beginning, all situate in Linn County, State of Oregon; said exception containing 6.01 acres, more or less, leaving in all 13.43 acres, more or less, all in Linn County, State of Oregon.


15. If the ground water supply is supplemental to an existing water supply, identification of any application for a permit, permit, certificate or adjudicated right to appropriate water made or held by the registrant.

Township 11 S Range 3 W, W.M.  
North

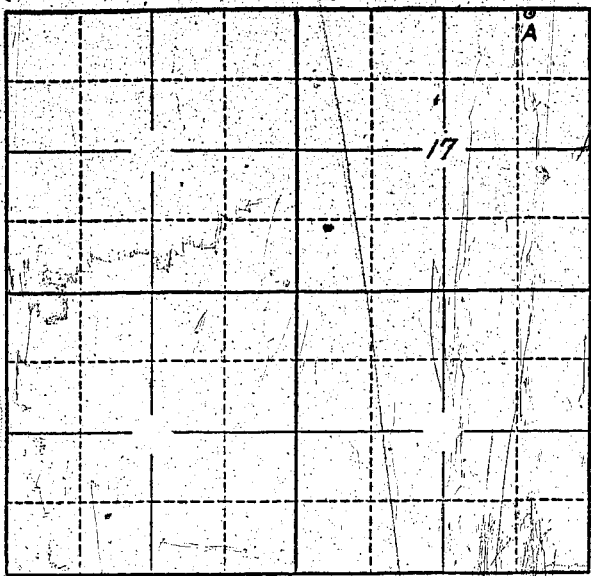

Locate well and acreage of irrigated land on plat:  
Scale: 2" = 1 Mile

STATE OF OREGON  
County of Linn } ss.

I, Richard and Erma Cushing, being first duly sworn, do hereby certify that I have read the foregoing Registration Statement and that all of the items therein contained are true to the best of my knowledge and belief.

Richard Cushing  
(Signature of Registrant)

Erma Cushing  
(Signature of Registrant)

Subscribed and sworn to before me this 13<sup>th</sup> day of July, 1957.

My commission expires  
NOTARY PUBLIC FOR OREGON  
My Commission Expires March 31, 1961  
(SEAL)

[Signature]  
(Notary Public)

**CERTIFICATE OF REGISTRATION**

STATE OF OREGON }  
County of Marion } ss.

This is to certify that the foregoing Registration Statement was received in the office of the State Engineer on the 5<sup>th</sup> day of June, 1958 at 8:00 o'clock A.M. and has been duly recorded in said office in Book No. 8 of Registration Statements on page GR-1616

Witness my hand this 7<sup>th</sup> day of January, 1959.

[Signature]  
(State Engineer)

By \_\_\_\_\_ (Deputy)

GR-1616

\$15.00