

RECEIVED
JUN 2 1946
STATE ENGINEER
SALEM OREGON

Registration No. GR 1666
Certificate No. GR 1617

Registration Statement

OF CLAIMANT OF RIGHT TO APPROPRIATE GROUND WATER

TO THE STATE ENGINEER OF OREGON:

I, Robert and Pauline Beach

of Route 4, Corvallis

(Mailing address)

County of Linn

State of Oregon, do hereby make application for a certificate of registration as evidence of a right to appropriate ground water.

1. Source from which water is withdrawn is pump well no. 1
(Flowing well, pump well, infiltration trench, or tunnel)

2. Location is: 1 1/2 miles East of Corvallis, Oregon
(Approximate distance and direction from nearest city or town)

and is more particularly described as follows:

(a) N. 62°30' East 12 Chains from NW corner of Pleasant Robinetta DLC
(Give distance and bearing to corner of section or other legal subdivision)

being within S 1/4 of SE 1/4 of Sec. 36, Twp. 11S, Rge. 5W.
(Smallest legal subdivision) (N. or S.) (E. or W.)

or (b) within limits of recorded platted property, town or city:

in Lot _____, Block _____ of _____
(Name of plat or addition)

(If within city or town, give name) County of Linn

3. Construction Work was begun on June, 1946; was completed on June, 1946
(Date) (Date)

and the ground water claimed was first used for the purposes set out below on June, 1946
(Date)

since which time the water has been used Continuously
(Continuously or intermittently)

from June, 1946 to present time
(Date) (Date)

4. Quantity of water claimed and used is 200 gallons per minute; 36.0 acre feet per year.

5. Purpose or Purposes for which water is used Irrigation

(Domestic, irrigation, municipal, manufacturing, industrial, etc.)

6. Description of Well: Depth 30 feet. Type Drilled
(Dug or drilled)

diameter 6 inches. Elevation of ground at well site 215 feet, mean sea level.
(As near as known)

Depth to water table 7 feet.

7. Capacity of Well: 300 g.p.m. with 6 feet drawdown.

_____ g.p.m. with _____ feet drawdown.


Date of test Estimated-not tested

If Flowing Well: Measured discharge _____ g.p.m. on _____ (Date)

Shut-in pressure at ground surface _____ lbs. per sq. in. on _____ (Date)

Water is controlled by _____
(Cap, valve, etc.)

Township 11 S. Range 5 W. W.M.
North

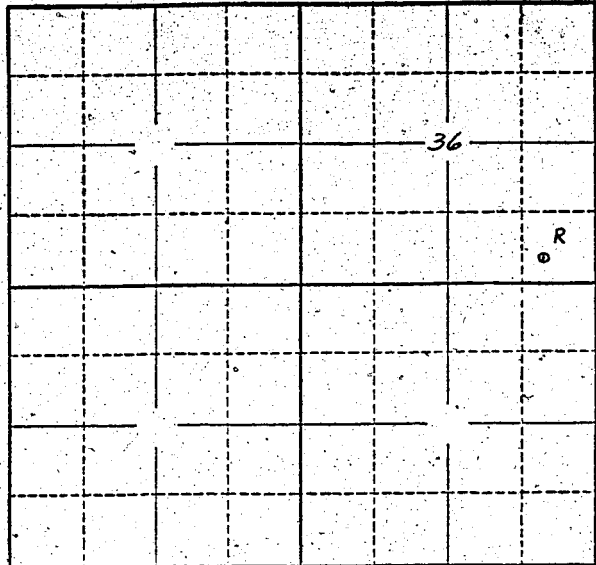

Locate well and acreage of irrigated land on plat.
Scale: 2" = 1 Mile

STATE OF OREGON
County of Linn } ss.

I, Robert and Pauline Beach, being first duly sworn, do hereby certify that I have read the foregoing Registration Statement and that all of the items therein contained are true to the best of my knowledge and belief.

Robert Beach
Pauline Beach
(Signature of Registrant)

Subscribed and sworn to before me this 2 day of June, 1958

My commission expires 6/27/59

Mary E. Gibson
(Notary Public for Oregon)
Commission Expires 6/27/59

(SEAL)

CERTIFICATE OF REGISTRATION

STATE OF OREGON
County of Marion } ss.

This is to certify that the foregoing Registration Statement was received in the office of the State Engineer on the 5th day of June, 1958, at E.C.C. o'clock A. M. and has been duly recorded in said office in Book No. 8 of Registration Statements on page GR-1617

Witness my hand this 7th day of January, 1959

Russ A. Stanley
(State Engineer)

By _____
(Deputy)

#1500

GR-1617