

Registration Statement

OF CLAIMANT OF RIGHT TO APPROPRIATE GROUND WATER

TO THE STATE ENGINEER OF OREGON:

I, MYRON O. LEHNE

of ROUTE 2, BOX 953, ROSEBURG, OREGON County of DOUGLAS
(Mailing address)

State of OREGON do hereby make application for a certificate of registration as evidence of a right to appropriate ground water.

1. Source from which water is withdrawn is PUMP WELL
(Flowing well, pump well, infiltration trench, or tunnel)

2. Location is: 10 MILES N.W. OF ROSEBURG, ORE.
(Approximate distance and direction from nearest city or town)

and is more particularly described as follows: 2460 ft. west & 2300 ft. north from SE corner Section 19

(a) 300 FT. S. AND 75 FT. E. OF N.W. CORNER LOT 2, BLOCK 7, PLATA
(Give distance and bearing to corner of section or other legal subdivision)

being within LOT 2 BLOCK 7 PLATA of Sec. 19, Twp. 26 S., Rge. 6 W.
(Section, legal subdivision) (N. or S.) (E. or W.)

or (b) within limits of recorded platted property, town or city:

in Lot _____, Block _____ of _____
(Name of plat or addition)

County of _____
(If within city or town, give name)

3. Construction Work was begun on 6/1/46; was completed on 6/15/46
(Date) (Date)

and the ground water claimed was first used for the purposes set out below on 6/15/46
(Date)

since which time the water has been used CONTINUOUSLY DURING SUMMER IRRIGATION SEASON
(Continuously or intermittently)

from 6/15/46 to Oct. 1957
(Date) (Date)

4. Quantity of water claimed and used is 80 gallons per minute; 40 acre feet per year.

5. Purpose or Purposes for which water is used IRRIGATION

(Domestic, irrigation, municipal, manufacturing, industrial, etc.)

6. Description of Well: Depth 29 feet. Type DRILLED + DUG
(Dug or drilled)

diameter 6 inches. Elevation of ground at well site 500 feet, mean sea level.
(As near as known)

Depth to water table 12 feet.

7. Capacity of Well: 80 g.p.m. with 4 feet drawdown.

_____ g.p.m. with _____ feet drawdown.


Date of test _____

If Flowing Well: Measured discharge _____ g.p.m. on _____
(Date)

Shut-in pressure at ground surface _____ lbs. per sq. in. on _____
(Date)

Water is controlled by _____
(Cap, valve, etc.)

Township 26 S. Range 6 W. W.M.
North

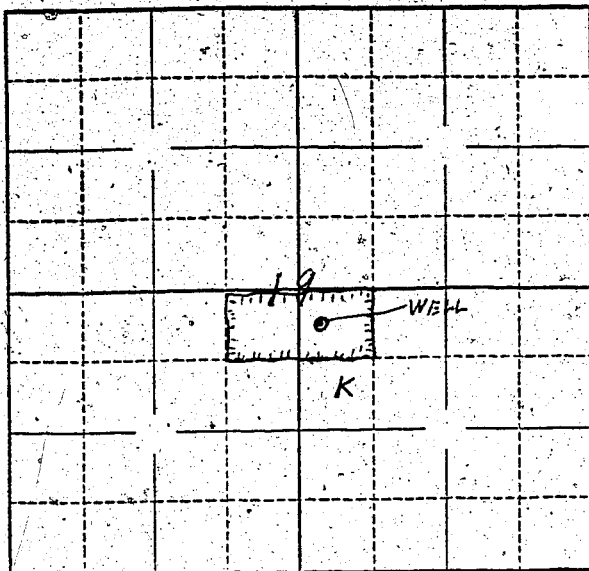

Locate well and acreage of irrigated land on plat.
Scale: 2" = 1 Mile

STATE OF OREGON

County of Columbia } ss.

I, Myron C. Lehne, being first duly sworn, do hereby certify that I have read the foregoing Registration Statement and that all of the items therein contained are true to the best of my knowledge and belief.

Myron C. Lehne
(Signature of Registrant)

Subscribed and sworn to before me this 3rd day of June, 1958

My commission expires June 6th 1958 Paul H. Thayer
(Notary Public)

(SEAL)

CERTIFICATE OF REGISTRATION

STATE OF OREGON

County of Marion } ss.

This is to certify that the foregoing Registration Statement was received in the office of the State Engineer on the 5th day of June, 1958, at 8:00 o'clock A. M. and has been duly recorded in said office in Book No. 8 of Registration Statements on page GR1619.

Witness my hand this 7th day of January, 1959

Lawrence A. Lattin
(State Engineer)

By _____ (Deputy)

\$15.00

GR-1619