

RECEIVED  
NOV 1 1956  
STATE ENGINEER  
SALEM, OREGON

REGISTRATION NO. GR-167

Registration Statement CERTIFICATE NO. GR-272

OF CLAIMANT OF RIGHT TO APPROPRIATE GROUND WATER

(Under Chapter 708, Oregon Laws 1955.)

TO THE STATE ENGINEER OF OREGON:

I, Flagmann Farms

of Rt. 2, Box 187, Albany County of Linn

State of Oregon, do hereby make application for a certificate of registration as evidence of a right to appropriate ground water.

1. Source from which water is withdrawn is Pump well No. 1  
(Flowing well, pump well, infiltration trench, or tunnel) ✓

2. Location is: 8 miles East of Albany, Oregon  
(Approximate distance and direction from nearest city or town)

and is more particularly described as follows:

(a) S. 26° E. 11.0 chains from the SE corner of the Lewis Cox D.L.C. 14  
(Give distance and bearing to corner of section or other legal subdivision) T 10 S, 2 W.

being within SE 1/4 of the NE 1/4 of Sec. 32, Twp. 10 S, Rge. 2 W.  
(Smallest legal subdivision) (N. or S.) (E. or W.)

or (b) within limits of recorded platted property, town or city:

in Lot \_\_\_\_\_, Block \_\_\_\_\_ of \_\_\_\_\_  
(Name of plat or addition)

County of Linn

(If within city or town, give name)

3. Construction Work was begun on 1935; was completed on 1935  
(Date) (Date)

and the ground water claimed was first used for the purposes set out below on 1935  
(Date)

since which time the water has been used continuously  
(Continuously or Intermittently)

from 1935 to present time  
(Date) (Date)

4. Quantity of water claimed and used is 525 gallons per minute; 105 acre feet per year.

5. Purpose or Purposes for which water is used: Irrigation

(Domestic, irrigation, municipal, manufacturing, industrial, etc.)

6. Description of Well: Depth 22 feet. Type drilled  
(Dug or drilled)

diameter 12 inches. Elevation of ground at well site 250 feet, mean sea level.  
(As near as known)

Depth to water table 4 feet.

7. Capacity of Well: 800 g.p.m. with 8 feet drawdown.

\_\_\_\_\_ g.p.m. with \_\_\_\_\_ feet drawdown.

Date of test Not tested

If Flowing Well: Measured discharge \_\_\_\_\_ g.p.m. on \_\_\_\_\_  
(Date)

Shut-in pressure at ground surface \_\_\_\_\_ lbs. per sq. in. on \_\_\_\_\_  
(Date)

Water is controlled by \_\_\_\_\_  
(Cap, valve, etc.)

8. Casing: (Give diameter, commercial specifications and depth below ground surface of each casing size.)

12 inch diameter steel from 0 to 22 feet  
inch diameter from to feet  
inch diameter from to feet  
inch diameter from to feet

Describe and show depth of shoe, plug, adapter, liner or other details:

9. Perforated Casings or Screens:

Bottom 5 feet of casing perforated  
(Number per foot and size of perforations, or describe screen)

from to  
from to  
from to  
from to

10. Log of Well: (Describe each stratum or formation clearly, indicate if water bearing, and give thickness and depth as indicated.)

MATERIAL	Thickness (Feet)	Depth to Bottom (Feet)
Not available		

Plagman Water Right

GR-272 A<sup>1</sup>

S.H.R.

1-

162-266

Beginning at a 1½"x16" iron pipe which is West 680.2 feet from a 6"x8"x14" stone in the center of the county road said stone being 9.50 chains South and 12.55 chains West from the Southeast corner of D.L.C.#44 in T. 10 S., R 2 W. of the Will. Mer. in Linn County, Oregon; and running thence West 565.5 feet to a point in the county road; thence S. 7°59' E. 20.0 feet to a 1½"x16" iron pipe; thence S. 7°59' E. 323.0 feet to a 1" iron pipe; thence S. 28°50' W. 296.3 feet to a 1½"x16" iron pipe; thence N. 59°59' W. 99.1 feet across a creek to a 1½"x16" iron pipe; thence S. 18°20' W. 197.8 feet to a 1" iron pipe; thence S. 6°04' E. 186.0 feet to a 1" iron pipe; thence S. 1°02' W. 1063.6 feet to a 1½"x16" iron pipe; thence continuing S. 1°02' W. 40.0 feet to the center of Mill Creek; thence up the center of Mill Creek 401.8 feet to a point on the North line of and S. 71°51' E. 822.1 feet from the Northwest corner of D.L.C. #38 in said Township and Range; thence S. 71°51' E. 40.0 feet to a 1½"x16" iron pipe; thence N. 23°55' E. 840.5 feet to a 8"x10"x14" stone; thence continuing N. 23°55' E. 493.7 feet; thence N. 52°00' E. 147.0 feet to a 1½"x16" iron pipe; thence N. 0°40' W. 1188.2 feet to the place of beginning containing 29.39 acres.

ALSO: Beginning at an iron pipe which is South 9.50 chains distant and West 12.55 chains distant from the Southeast corner of the D.L.C. of Lewis Cox and wife same being Not. #1626 and Cl. #44 in T. 10 S., R 2 W. of the Will. Mer. in Linn County, Oregon; thence South 17.14 chains to an iron pipe; thence S. 63°15' E. 5.36 chains to an iron pipe; thence S. 27½° E. 2.49 chains to an iron pipe; thence S. 23° West 6.50 chains to the center of Spring Creek; thence S. 50° W. along the center of said Creek 11 chains; thence South along the center of said Creek 3.19 chains; thence North 75°30' W. 1.89 chains to a stone 6x6x12" marked with a - on top; thence N. 35°45' W. 14.20 chains to a stone 8"x10"x14" thence N. 24½° E. 7.33 chains to an iron pipe; thence N. 54° E. 2.26 chains to an iron pipe; thence North 18 chains to an iron pipe which is West 10.30 chains from the place of beginning; thence East 10.30 chains to the place of beginning containing 44.44 acres, more or less. Excepting a right-of-way more particularly described in Deed Vol. 136 Pg. 80

ALSO: Beginning at the Northeast corner of the D.L.C. of John A. Powell Cl. #40 in T. 11 S., R 2 W. of the Will. Mer. in Linn County, Oregon; thence North 5.34 chains; thence N. 73°20' W. 20.30 chains; thence N. 35°30' W. 14.30 chains; thence S. 24½° W. 12.67 chains to the North line of said Cl. #38; thence S. 71°15' E. 29.49 chains to beginning containing 19.93 acres, more or less lying and being in Linn County, State of Oregon.

243-24

Plagman Water Right

beginning at an iron pipe which is South 31.17 chains distant and West 5.62 chains distant from the Southeast corner of the D.L.C. of Lewis Cox and wife being Not. #1626 and Cl. #44 in T. 10 S., R 2 W. of the Will. Mer. in Linn County, Oregon; thence East 32.14 chains to an iron pipe; thence South 2½° West 6.17 chains; thence S. 42° West 11.85 chains; thence S. 15° E. 10.24 chains to the South line of Section 33 in said Township and Range; thence S. 3.08 chains; thence West 14 chains; thence North 5.43 chains; thence N. 77 3/4° West 21.15 chains; thence N. 75°30' W. 3.11 chains to the center of Spring Creek; thence up the center of said creek North 3.19 chains; thence N. 50° East along the center of said creek 11 chains; thence N. 23° E. 6.50 chains to the place of beginning.

141-370

Beginning at the Northeast corner of the D.L.C. of J. A. Powell Not. #1197 and Cl. #40 in T. 11 S., R 2 W. of the Will. Mer. in Linn County, Oregon; thence running North 5.34 chains; thence S.  $73^{\circ}30'$  E. 6.45 chains; thence South 3.05 chains; thence East 14 chains; thence North ~~288~~ 2.88 chains to the North boundary line of Section 4 in said Township and Range; thence East 20.15 chains; thence South 15.00 chains; thence West 14.79 chains; thence South 2.73 chains to the center of a certain slough; thence following the center of said slough in a Northerly and Westerly direction to the East boundary line of said Cl. #40; thence; thence N.  $18^{\circ}45'$  E. 8.00 chains to the beginning containing 51.03 acres, more or less situated in Linn County, State of Oregon. Excepting a right-of-way bounded and described as follows: Beginning at a point 29 feet North and 10 feet East of the Northeast corner of J. A. Powell D.L.C. #40 in T. 11 S., R 2 W. of the Will. Mer. in Linn County, Oregon; thence running S.  $18^{\circ}45'$  W. 7.50 chains; more or less parallel with the East line of said Cl. #40 and at right angles 10 feet distant to a point 10 feet North of the top of the bank of a certain slough; thence following said slough in an Easterly direction and 10 feet distant from the top of the bank of said slough to a point which is 9.06 chains South and 9.60 chains East from the point of beginning said right-of-way to be 20 feet in width and 10 feet on each side of the above described line.

243-23

Beginning at an iron pipe which is South 20.64 chains distant and West 12.65 chains distant from the Southeast corner of the D.L.C. Claim of Lewis Cox and wife same being Not. #1626 and Cl. #44 in T. 10 S., R 2 W. of the Will. Mer. in Linn County, Oregon; thence South 6 chains to an iron pipe; thence S.  $63^{\circ}15'$  E. 5.36 chains to an iron pipe; thence S.  $27\frac{1}{2}^{\circ}$  E. 2.49 chains to an iron pipe; thence East 32.14 chains; thence N.  $2\frac{1}{2}^{\circ}$  E. 1.85 chains; thence N.  $17\frac{1}{2}^{\circ}$  E. 3.40 chains; thence N.  $4\frac{1}{2}^{\circ}$  E. 5.46 chains to a stone; thence West 39.60 chains to the place of beginning. ALSO a right-of-way ~~and~~ for road purposes which begins at a point 9.50 chains South and 12.55 chains West from the Southeast corner of said Cl. #44; thence South 17.14 chains; thence S.  $63^{\circ}15'$  E. 5.36 chains; thence S.  $27\frac{1}{2}^{\circ}$  E. 2.49 chains; thence South  $23^{\circ}$  West 76 links; thence North  $27\frac{1}{2}^{\circ}$  West 2.80 chains; thence North  $63^{\circ}15'$  W. 5.54 chains; thence North 17.51 chains; thence East 60 links to the place of beginning all lying in Linn County, Oregon

ALSO Beginning at a point which is South 20.64 chains distant and East 27.05 chains distant from the Southeast corner of the D.L.C. of Lewis Cox and wife same being Not. #1626 and Cl. #44 in T. 10 S., R 2 W. of the Will. Mer. in Linn County, Oregon; thence S.  $4\frac{1}{2}^{\circ}$  W. 5.46 chains; thence S.  $17\frac{1}{2}^{\circ}$  W. 3.40 chains; thence S.  $2\frac{1}{2}^{\circ}$  W. 8.02 chains; thence S.  $42^{\circ}$  W. 11.85 chains; thence S.  $15^{\circ}$  E. 10.24 chains to the South line of Section 3 in said township and range; thence East 20.79 chains to the East boundary line of Cl. #39 in said Township and range; thence North along the East boundary line of said Claim 34.59 chains to the place of beginning all lying in Linn County, State of Ore. *thence W. 15.70 ch.*

ALSO Beginning at an iron pipe which is South 20.64 chains distant and West 12.65 chains distant from the Southeast corner of the D.L.C. of Lewis Cox and wife same being Not. #1626 and Cl. #44 in T. 10 S., R 2 W. of the Will. Mer. in Linn County, Oregon; thence South 6 chains to an iron pipe; thence S.  $63^{\circ}15'$  E. 5.36 chains to an iron pipe; thence S.  $27\frac{1}{2}^{\circ}$  E. 2.49 chains to an iron pipe; thence East 32.14 chains; thence N.  $2\frac{1}{2}^{\circ}$  E. 1.85 chains; thence N.  $17\frac{1}{2}^{\circ}$  E. 3.40 chains; thence N.  $4\frac{1}{2}^{\circ}$  E. 5.46 chains to a stone; thence West 39.60 chains to the place of beginning.

ALSO a right-of-way for road purposes which beginning at a point 9.50 chains South and 12.55 chains West from the Southeast corner of said Cl. #44; thence South 17.14 chains; thence S.  $63^{\circ}15'$  E. 5.36 chains; thence S.  $27\frac{1}{2}^{\circ}$  E. 2.49 chains; thence S.  $23^{\circ}$  W. 76 links; thence N.  $27\frac{1}{2}^{\circ}$  W. 2.80 chains; thence N.  $63^{\circ}15'$  W. 5.54 chains; thence North 17.51 chains; thence East 60 links to the place of beginning all lying in Linn County, State of Oregon.

Beginning 9.40 chains South and 2.55 chains West from the Southeast corner of the D.L.C. of Lewis Cox and wife Cl. #44 in T. 10 S., R 2 W. of the Will. Mer. in Linn County, Oregon; and running thence West 11 chains; thence South 11.14 chains thence East 35.82 chains; thence North 11.21 chains; thence West 24.82 chains to the place of beginning containing 40.01 acres, more or less in Linn County, Oregon. ALSO Beginning at the Northeast corner of the tract of land above described the same being the tract of land heretofore conveyed to Ada Robson and W.L. Lyon conveyances of which is recorded in Vol. 47 of Deeds Page 173 therein and running thence East 6 chains thence South 3 chains; thence S. 29° W. 2.50 chains; thence S. 14½° W. 2.50 chains thence S. 7° W. 3.50 chains; thence West 3.81 chains, more or less to the Southeast corner of the tract afore said; thence North 11.21 chains to the place of beginning; the intention being to make the East line of the property hereby conveyed to conform to the West line or bank of the old channel of the South Fork of the Santiam River and said property hereby conveyed containing 5 acres, more or less in Linn County, Oregon and the aggregate amount of land hereby conveyed containing 45.01 acres, more or less all in Linn County, Oregon.

141-369

Beginning at the Northeast corner of the D.L.C. of J. R. Powell Not. #1197 and Cl. #40 in T. 11 S., R 2 W. of the Will. Mer. in Linn County, Oregon; thence running North 5.34 chains; thence S. 73°30' E. 6.45 chains; thence S. 3.05 chains; thence East 14.00 chains; thence North 2.88 chains to the North boundary line of Section 4 in T. 11-2 W. etc. thence East 20.15 chains; thence South 15.00 chains; thence West 14.79 chains; thence South 2.73 chains to the center of a certain slough; thence following the center of said slough in a Northerly and Westerly direction to the East boundary line of said Cl. #40; thence N. 18°45' E. 8.00 chains to the beginning containing 51.03 acres, more or less situated in Linn County, State of Oregon. Excepting a right-of-way bounded and described as follows: Beginning at a point 20 feet North and 10 feet East of the Northeast corner of the J.A. Powell's D.L.C. #40 in T. 11 S., R 2 W. of the Will. Mer. in Linn County, Oregon; thence running S. 18°45' W. 7.50 chains, more or less parallel with the East line of said Cl. #40 and at right angles 10 feet distant to a point 10 feet North of the top of the bank of a certain slough; thence following said slough in a Easterly direction and 10 feet distant from the top of the bank of said slough to a point which is 8.06 chains South and 9.60 chains East from the point of beginning said right-of-way to be 20 feet in width and 10 feet on each side of the above described line.

If log of well is not available, give name and address of driller. Willard Sloper. Rt. 4, Albany, Ore.

11. Infiltration Trench: Covered or open .....

Dimensions: Length ..... ft. Minimum depth ..... ft. Maximum depth ..... ft.

Bottom width ..... ft. Discharge ..... g.p.m. Date of test .....

12. Tunnel: Type of lining .....

Dimensions: .....  
(Length, course, and cross sectional size)

Position of water bearing stratum with reference to portal of tunnel .....

Log of tunnel: (Preceding table for log of well may be used, if desired. Give footage from portal and character of materials, as pertinent.)

13. Pumping Equipment:

(a) Pump 3" Fairbank Morse Centrifugal Capacity 600 g.p.m.  
(Make, type and size)


(b) Motor 20 H. P. Electric  
(Type and horsepower)

14. Location of area irrigated or to be irrigated, or place of use if for purposes other than irrigation.

Township North or South	Range E. or W. of Willamette Meridian	Section	Forty-acre Tract	Number Acres To Be Irrigated	Date of Reclamation
10 S	2 W	32	SE $\frac{1}{4}$ of NE $\frac{1}{4}$	7.3	1935
10 S	2 W	32	NE $\frac{1}{4}$ of SE $\frac{1}{4}$	10.1	1935
10 S	2 W	33	SW $\frac{1}{4}$ of NW $\frac{1}{4}$	10.0	1935
10 S	2 W	33	SE $\frac{1}{4}$ of NW $\frac{1}{4}$	1.0	1935
10 S	2 W	33	NW $\frac{1}{4}$ of SW $\frac{1}{4}$	12.4	1935
10 S	2 W	33	NE $\frac{1}{4}$ of SW $\frac{1}{4}$	1.2	1935
				42.0	

15. If the ground water supply is supplemental to an existing water supply, identification of any application for a permit, permit, certificate or adjudicated right to appropriate water made or held by the registrant.

Township 10 Range 2 W, W.M.  
North

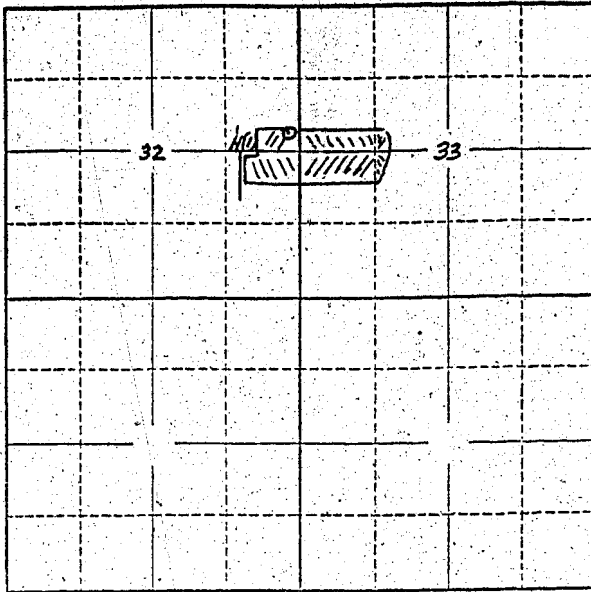

Locate well and acreage of irrigated land on plat.  
Scale: 2" = 1 Mile

STATE OF OREGON  
County of Linn

} ss.

I, Plagmann Farms, being first duly sworn, do hereby certify that I have read the foregoing Registration Statement and that all of the items therein contained are true to the best of my knowledge and belief.

(Signature of Registrant)

Subscribed and sworn to before me this \_\_\_\_\_ day of \_\_\_\_\_, 19\_\_\_\_.

My commission expires \_\_\_\_\_  
(Notary Public)

(SEAL)

SEE PAGE GR-272-W FOR  
CERTIFICATE OF REGISTRATION

STATE OF OREGON  
County of Marion

} ss.

~~This is to certify that the foregoing Registration Statement was received in the office of the State Engineer on the \_\_\_\_\_ day of \_\_\_\_\_, 19\_\_\_\_, at \_\_\_\_\_, Oregon, and has been duly recorded in Book No. \_\_\_\_\_ of Registration Statements, page \_\_\_\_\_ of Construction Plans completed by \_\_\_\_\_, and the water right applied to \_\_\_\_\_ by \_\_\_\_\_.~~

Witness my hand this \_\_\_\_\_ day of \_\_\_\_\_, 19\_\_\_\_.

(State Engineer)

By \_\_\_\_\_  
(Deputy)

GR-272 C

RECEIVED  
NOV 1 1956  
STATE ENGINEER  
SALEM, OREGON

REGISTRATION NO. GR-167

Registration Statement

CERTIFICATE NO. GR-272

OF CLAIMANT OF RIGHT TO APPROPRIATE GROUND WATER

(Under Chapter 708, Oregon Laws 1955.)

TO THE STATE ENGINEER OF OREGON:

I, Flagmann Farms  
of Rt. 2, Box 487, Albany County of Linn

State of Oregon, do hereby make application for a certificate of registration as evidence of a right to appropriate ground water.

1. Source from which water is withdrawn is Pump Well No. 2  
(Flowing well, pump well, infiltration trench, or tunnel)

2. Location is: 8 miles East of Albany, Oregon  
(Approximate distance and direction from nearest city or town)

and is more particularly described as follows:

(a) N. 10° 43' W. 29.5 chains from the NE corner of the John A. Powell D.L.C. 38  
(Give distance and bearing to corner of section or other legal subdivision) 11 S, 2 W.

being within NE 1/4 of SE 1/4 of Sec. 32, Twp. 10 S Rge. 2 W  
(Smallest legal subdivision) (N. or S.) (E. or W.)

or (b) within limits of recorded platted property, town or city:

in Lot \_\_\_\_\_, Block \_\_\_\_\_ of \_\_\_\_\_  
(Name of plat or addition)  
County of Linn  
(If within city or town, give name)

3. Construction Work was begun on 1940; was completed on 1940  
(Date) (Date)

and the ground water claimed was first used for the purposes set out below on 1940  
(Date)

since which time the water has been used Continuously  
(Continuously or Intermittently)

from 1940 to present time  
(Date) (Date)

4. Quantity of water claimed and used is 525 gallons per minute; 100 acre feet per year.

5. Purpose or Purposes for which water is used Irrigation

(Domestic, irrigation, municipal, manufacturing, industrial, etc.)

6. Description of Well: Depth 20 feet. Type Drilled  
(Dug or drilled)

diameter 12 inches. Elevation of ground at well site 250 feet, mean sea level.  
(As near as known)

Depth to water table 8 feet.

7. Capacity of Well: 800 g.p.m. with 10 feet drawdown.

\_\_\_\_\_ g.p.m. with \_\_\_\_\_ feet drawdown.

Date of test Not tested

If Flowing Well: Measured discharge \_\_\_\_\_ g.p.m. on \_\_\_\_\_  
(Date)

Shut-in pressure at ground surface \_\_\_\_\_ lbs. per sq. in. on \_\_\_\_\_  
(Date)

Water is controlled by \_\_\_\_\_  
(Cap, valve, etc.)

GR-272 D





If log of well is not available, give name and address of driller. T. J. Burkhardt, 159 N. 1st W.  
Tremonton, Utah

11. Infiltration Trench: Covered or open:.....  
 Dimensions: Length ..... ft. Minimum depth ..... ft. Maximum depth ..... ft.  
 Bottom width ..... ft. Discharge ..... g.p.m. Date of test .....

12. Tunnel: Type of lining .....  
 Dimensions: .....  
(Length, course, and cross sectional size)  
 Position of water bearing stratum with reference to portal of tunnel .....

Log of tunnel: (Preceding table for log of well may be used, if desired. Give footage from portal and character of materials, as pertinent.)


13. Pumping Equipment:  
 (a) Pump ..... 3" Wyss Centrifugal ..... Capacity 600 g.p.m.  
(Make, type and size)  
 (b) Motor ..... 20 H. P. Electric .....  
(Type and horsepower)

14. Location of area irrigated or to be irrigated, or place of use if for purposes other than irrigation.

Township North or South	Range E. or W. of Willamette Meridian	Section	Forty-acre Tract	Number Acres To Be Irrigated	Date of Reclamation
10 S.	2 W	32	NE $\frac{1}{4}$ of SE $\frac{1}{4}$	20.6	1940
10 S	2 W	32	SE $\frac{1}{4}$ of SE $\frac{1}{4}$	3.4	1940
10 S	2 W	33	NW $\frac{1}{4}$ of SW $\frac{1}{4}$	15.4	1940
10 S	2 W	33	SW $\frac{1}{4}$ of SW $\frac{1}{4}$	0.6	1940
				40.0	

15. If the ground water supply is supplemental to an existing water supply, identification of any application for a permit, permit, certificate or adjudicated right to appropriate water made or held by the registrant.

Township 10 S. Range 2 W., W.M.  
North

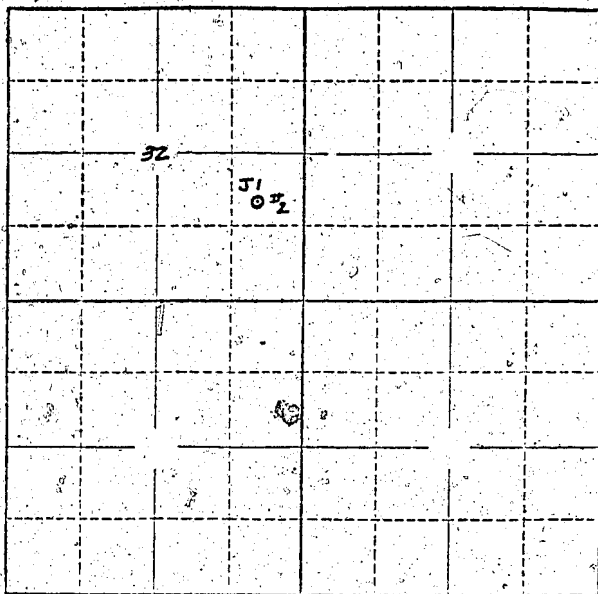

Locate well and acreage of irrigated land on plat.  
Scale: 2" = 1 Mile

STATE OF OREGON }  
County of Linn } ss.

I, Flagmann Farms, being first duly sworn, do hereby certify that I have read the foregoing Registration Statement and that all of the items therein contained are true to the best of my knowledge and belief.

.....  
(Signature of Registrant)

Subscribed and sworn to before me this ..... day of ....., 19.....

My commission expires .....  
(Notary Public)

(SEAL)

SEE PAGE GR-272-W FOR  
CERTIFICATE OF REGISTRATION

STATE OF OREGON }  
County of Marion } ss.

~~This is to certify that the foregoing Registration Statement was received in the office of the State Engineer on the X-X-X day of X-X-X-X, 19X-X, at X-X-X-X o'clock X-X-X and has been duly recorded in said office in Book No. X-X-X-X of Registration Statements on page X-X-X-X-X-X-X-X. Construction shall be completed by X-X-X-X-X-X-X-X and the water completely applied to beneficial use by X-X-X-X-X-X-X-X.~~

Witness my hand this ..... day of ....., 19.....

.....  
(State Engineer)

By .....  
(Deputy)

GR-272G

RECEIVED  
NOV 1 1956  
STATE ENGINEER  
SALEM, OREGON

REGISTRATION NO. GR-167  
CERTIFICATE NO. GR-272

### Registration Statement

#### OF CLAIMANT OF RIGHT TO APPROPRIATE GROUND WATER

(Under Chapter 708, Oregon Laws 1955.)

TO THE STATE ENGINEER OF OREGON:

I, Plagmann Farms

of Rt. 2, Box 487, Albany County of Linn

State of Oregon, do hereby make application for a certificate of registration as evidence of a right to appropriate ground water.

1. Source from which water is withdrawn is Pump Well No. 3  
(Flowing well, pump well, infiltration trench, or tunnel)

2. Location is: 8 miles East of Albany, Oregon  
(Approximate distance and direction from nearest city or town)

and is more particularly described as follows:

(a) N. 86° 45' E. 8.25 chains from the NE corner of the John A. Powell, D.L.C. 38,  
(Give distance and bearing to corner of section or other legal subdivision) T. 11 S., 2 W.  
being within NW 1/4 of NW 1/4 of Sec. 4, Twp. 11 S., Rge. 2 W.  
(Smallest legal subdivision) (N. or S.) (E. or W.)

or (b) within limits of recorded platted property, town or city:

in Lot \_\_\_\_\_, Block \_\_\_\_\_ of \_\_\_\_\_  
(Name of plat or addition)

County of Linn  
(If within city or town, give name)

3. Construction Work was begun on 1942; was completed on 1942  
(Date) (Date)

and the ground water claimed was first used for the purposes set out below on 1942  
(Date)

since which time the water has been used continuously  
(Continuously or intermittently)

from 1942 to present time  
(Date) (Date)

4. Quantity of water claimed and used is 1525 gallons per minute; 80 acre  
feet per year.

5. Purpose or Purposes for which water is used Irrigation

(Domestic, irrigation, municipal, manufacturing, industrial, etc.)

6. Description of Well: Depth 28 feet. Type Drilled  
(Dug or drilled)

diameter 10 inches. Elevation of ground at well site 250 feet, mean sea level.  
(As near as known)

Depth to water table 15 feet.

7. Capacity of Well: 800 g.p.m. with 10 feet drawdown.

       g.p.m. with        feet drawdown.

Date of test Not tested

If Flowing Well: Measured discharge        g.p.m. on        (Date)

Shut-in pressure at ground surface        lbs. per sq. in. on        (Date)

Water is controlled by         
(Cap, valve, etc.)

GR-272H

8. Casing: (Give diameter, commercial specifications and depth below ground surface of each casing size.)

10 inch diameter steel from 0 to 28 feet  
 inch diameter from to feet  
 inch diameter from to feet  
 inch diameter from to feet

Describe and show depth of shoe, plug, adapter, liner or other details: .....

9. Perforated Casings or Screens:

Bottom 5 feet of casing perforated from to  
(Number per foot and size of perforations, or describe screen)  
 from to  
 from to  
 from to

10. Log of Well: (Describe each stratum or formation clearly, indicate if water bearing, and give thickness and depth as indicated.)

MATERIAL	Thickness (Feet)	Depth to Bottom (Feet)
Not available		

If log of well is not available, give name and address of driller. T. J. Burkhart, 169 N. 1st W.  
Tremonton, Utah

11. Infiltration Trench: Covered or open .....  
 Dimensions: Length ..... ft. Minimum depth ..... ft. Maximum depth ..... ft.  
 Bottom width ..... ft. Discharge ..... g.p.m. Date of test .....

12. Tunnel: Type of lining .....  
 Dimensions: .....  
(Length, course, and cross sectional size)  
 Position of water bearing stratum with reference to portal of tunnel .....

Log of tunnel: (Preceding table for log of well may be used, if desired. Give footage from portal and character of materials, as pertinent.)


13. Pumping Equipment:  
 (a) Pump ..... 3" Chrysler Centrifugal ..... Capacity 600 ..... g.p.m.  
(Make, type and size)  
 (b) Motor ..... Chrysler Industrial .....  
(Type and horsepower)

14. Location of area irrigated or to be irrigated, or place of use if for purposes other than irrigation.

Township North or South	Range E. or W. of Willamette Meridian	Section	Forty-acre Tract	Number Acres To Be Irrigated	Date of Reclamation
10 S	2 W	32	SE $\frac{1}{4}$ of SE $\frac{1}{4}$	2.0	1942
10 S	2 W	33	SW $\frac{1}{4}$ of SW $\frac{1}{4}$	8.5	1942
11 S	2 W	4	NW $\frac{1}{4}$ of NW $\frac{1}{4}$	10.5	1942
11 S	2 W	5	NE $\frac{1}{4}$ of NE $\frac{1}{4}$	11.0	1942
				32.0	

15. If the ground water supply is supplemental to an existing water supply, identification of any application for a permit, permit, certificate or adjudicated right to appropriate water made or held by the registrant.

Township 10 & 11 S Range 2 W, W.M.  
North

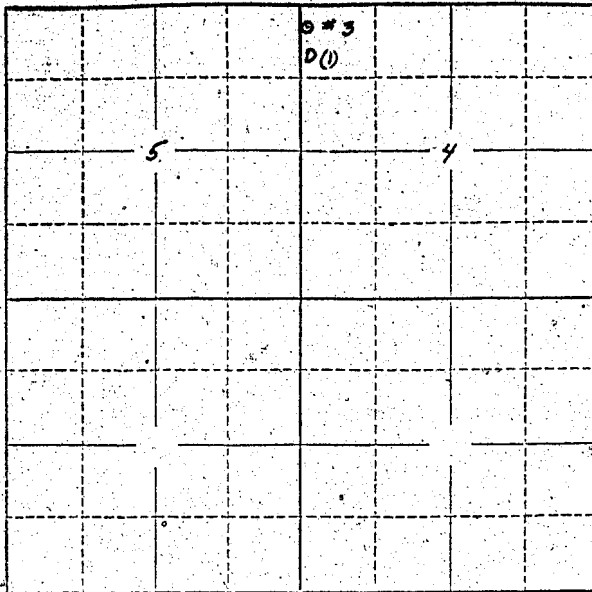

Locate well and acreage of irrigated land on plat.  
Scale: 2" = 1 Mile

STATE OF OREGON

County of Linn } ss.

I, Plagmann Farms, being first duly sworn, do hereby certify that I have read the foregoing Registration Statement and that all of the items therein contained are true to the best of my knowledge and belief.

(Signature of Registrant)

Subscribed and sworn to before me this \_\_\_\_\_ day of \_\_\_\_\_, 19\_\_\_\_\_

My commission expires \_\_\_\_\_ (Notary Public)

(SEAL)

SEE PAGE GR-272-W FOR  
CERTIFICATE OF REGISTRATION

STATE OF OREGON

County of Marion } ss.

~~This is to certify that the foregoing Registration Statement was recorded in the office of the State Engineer on the \_\_\_\_\_ day of \_\_\_\_\_, 19\_\_\_\_ and has been duly recorded in said office in Book No. \_\_\_\_\_ of Registration Statements on page \_\_\_\_\_ and the same shall be completed by \_\_\_\_\_ and the same copy filed to heretofore by \_\_\_\_\_.~~

Witness my hand this \_\_\_\_\_ day of \_\_\_\_\_, 19\_\_\_\_\_

(State Engineer)

By \_\_\_\_\_ (Deputy)

GR-272 K

RECEIVED  
NOV 1 1956  
STATE ENGINEER  
SALEM, OREGON

REGISTRATION NO. GR-167  
CERTIFICATE NO. GR-272

# Registration Statement

## OF CLAIMANT OF RIGHT TO APPROPRIATE GROUND WATER

(Under Chapter 708, Oregon Laws 1955.)

TO THE STATE ENGINEER OF OREGON:

I, Flagnann Farms

of Rt. 2, Box 487, Albany County of Linn

State of Oregon, do hereby make application for a certificate of registration as evidence of a right to appropriate ground water.

1. Source from which water is withdrawn is Pump Well No. 4  
(Flowing well, pump well, infiltration trench, or tunnel)

2. Location is: 8 Miles East of Albany, Oregon  
(Approximate distance and direction from nearest city or town)

and is more particularly described as follows:

(a) N. 40° 30' 39.5 chains from the NE corner of the John A. Powell, D.L.G. 38,  
(Give distance and bearing to corner of section or other legal subdivision) T. 11 S., R. 2 W.

being within NW 1/4 of SE 1/4 of Sec. 32, Twp. 10 S., Rge. 2 W.  
(Smallest legal subdivision) (N. or S.) (E. or W.)

or (b) within limits of recorded platted property, town or city:

in Lot \_\_\_\_\_, Block \_\_\_\_\_ of \_\_\_\_\_  
(Name of plat or addition)

County of Linn  
(If within city or town, give name)

3. Construction Work was begun on 1943; was completed on 1943  
(Date) (Date)

and the ground water claimed was first used for the purposes set out below on 1943  
(Date)

since which time the water has been used continuously  
(Continuously or intermittently)

from 1943 to Present time  
(Date) (Date)

4. Quantity of water claimed and used is 400 gallons per minute; 100 acre feet per year.

5. Purpose or Purposes for which water is used Irrigation  
(Domestic, irrigation, municipal, manufacturing, industrial, etc.)

6. Description of Well: Depth 8 feet. Type Drilled  
(Dug or drilled)

diameter 8 inches. Elevation of ground at well site 250 feet, mean sea level.  
(As near as known)

Depth to water table 2 feet.

7. Capacity of Well: 1000 g.p.m. with 3 feet drawdown.

       g.p.m. with        feet drawdown.

Date of test Not tested

If Flowing Well: Measured discharge        g.p.m. on         
(Date)

Shut-in pressure at ground surface        lbs. per sq. in. on         
(Date)

Water is controlled by         
(Cap, valve, etc.)

GR-272 L



8. Casing: (Give diameter, commercial specifications and depth below ground surface of each casing size.)

8 inch diameter steel from 0 to 8 feet  
inch diameter from to feet  
inch diameter from to feet  
inch diameter from to feet

Describe and show depth of shoe, plug, adapter, liner or other details:

9. Perforated Casings or Screens:

Bottom 5 feet of casing perforated from to  
(Number per foot and size of perforations, or describe screen)  
from to  
from to  
from to

10. Log of Well: (Describe each stratum or formation clearly, indicate if water bearing, and give thickness and depth as indicated.)

MATERIAL	Thickness (Feet)	Depth to Bottom (Feet)
Log not available		

If log of well is not available, give name and address of driller. T. J. Burkhart, 169 N. 1st W.

Tremonton, Utah

11. Infiltration Trench: Covered or open .....

Dimensions: Length ..... ft. Minimum depth ..... ft. Maximum depth ..... ft.

Bottom width ..... ft. Discharge ..... g.p.m. Date of test .....

12. Tunnel: Type of lining .....

Dimensions: .....

(Length, course, and cross sectional size)

Position of water bearing stratum with reference to portal of tunnel .....

Log of tunnel: (Preceding table for log of well may be used, if desired. Give footage from portal and character of materials, as pertinent.)

13. Pumping Equipment:

(a) Pump ..... 3<sup>rd</sup> Fairbanks Morse Centrifugal ..... Capacity 500 ..... g.p.m.  
(Make, type and size)

(b) Motor ..... 15 H. P. electric .....  
(Type and horsepower)

14. Location of area irrigated or to be irrigated, or place of use if for purposes other than irrigation.

Township North or South	Range E. or W. of Willamette Meridian	Section	Forty-acre Tract	Number Acres To Be Irrigated	Date of Reclamation
10 S	2 W	32	NE $\frac{1}{4}$ of SW $\frac{1}{4}$	0.9	1943
10 S	2 W	32	SE $\frac{1}{4}$ of SW $\frac{1}{4}$	0.7	1943
10 S	2 W	32	NW $\frac{1}{4}$ of SE $\frac{1}{4}$	12.1	1943
10 S	2 W	32	NE $\frac{1}{4}$ of SE $\frac{1}{4}$	1.0	1943
10 S	2 W	32	SE $\frac{1}{4}$ of SE $\frac{1}{4}$	1.3	1943
10 S	2 W	32	SW $\frac{1}{4}$ of SE $\frac{1}{4}$	24.0	1943
				40.0	

15. If the ground water supply is supplemental to an existing water supply, identification of any application for a permit, permit, certificate or adjudicated right to appropriate water made or held by the registrant.

Township 10 S Range 2 W, W.M.  
North

		32				
		K O #4				

Locate well and acreage of irrigated land on plat.  
Scale: 2" = 1 Mile

STATE OF OREGON

County of Linn } ss.

I, Plagmann Farms, being first duly sworn, do hereby certify that I have read the foregoing Registration Statement and that all of the items therein contained are true to the best of my knowledge and belief.

.....  
(Signature of Registrant)

Subscribed and sworn to before me this ..... day of ....., 19.....

My commission expires .....  
(Notary Public)

(SEAL)

**SEE PAGE GR-272-W FOR  
CERTIFICATE OF REGISTRATION**

STATE OF OREGON }  
County of Marion } ss.

~~This is to certify that the foregoing Registration Statement was received in the office of the State Engineer on the XX-XX-XX day of XX-XX-XX 19XX and that the same has been recorded in the books of the State Engineer in accordance with the provisions of the laws of the State of Oregon.~~

Witness my hand this ..... day of ....., 19.....

.....  
(State Engineer)

By .....  
(Deputy)

RECEIVED  
NOV 1 1956  
STATE ENGINEER  
SALEM, OREGON

REGISTRATION NO. GR-167

# Registration Statement

CERTIFICATE NO. GR-272

## OF CLAIMANT OF RIGHT TO APPROPRIATE GROUND WATER

(Under Chapter 708, Oregon Laws 1955.)

TO THE STATE ENGINEER OF OREGON:

I, Flagmann Farms

of Rt. 2, Box 487, Albany County of Linn

State of Oregon, do hereby make application for a certificate of registration as evidence of a right to appropriate ground water.

1. Source from which water is withdrawn is Pit Well No. 5

(Flowing well, pump well, infiltration trench, or tunnel)

2. Location is: N. 34° 15' W., 36.5 chains from the NE corner of the John A. Powell, DLC 38

(Approximate distance and direction from nearest city or town) T. 11 S., R. 2 W

and is more particularly described as follows:

(a)

(Give distance and bearing to corner of section or other legal subdivision)

being within NW<sup>1</sup> of SE<sup>1</sup> of Sec. 32, Twp. 10 S., Rge. 2 W.

(Smallest legal subdivision)

(N. or S.)

(E. or W.)

or (b) within limits of recorded platted property, town or city:

in Lot \_\_\_\_\_, Block \_\_\_\_\_ of \_\_\_\_\_

(Name of plat or addition)

County of Linn

(If within city or town, give name)

3. Construction Work was begun on 1944, was completed on 1944

(Date)

(Date)

and the ground water claimed was first used for the purposes set out below on 1944

(Date)

since which time the water has been used continuously

(Continuously or intermittently)

from 1944 to present time

(Date)

(Date)

4. Quantity of water claimed and used is 360 gallons per minute; 80 acre feet per year.

5. Purpose or Purposes for which water is used Irrigation

(Domestic, irrigation, municipal, manufacturing, industrial, etc.)

6. Description of Well: Depth 20 feet. Type Dug

(Dug or drilled)

diameter Pit inches. Elevation of ground at well site 250 feet, mean sea level.

(As near as known)

Depth to water table 6 feet.

7. Capacity of Well: 800 g.p.m. with 4 feet drawdown.

         g.p.m. with          feet drawdown.

Date of test Not tested

If Flowing Well: Measured discharge          g.p.m. on         

(Date)

Shut-in pressure at ground surface          lbs. per sq. in. on         

(Date)

Water is controlled by         

(Cap, valve, etc.)

GR-272 P

8. Casing: (Give diameter, commercial specifications and depth below ground surface of each casing size.)

..... inch diameter **No casing - pit** ..... from ..... to ..... feet  
..... inch diameter ..... from ..... to ..... feet  
..... inch diameter ..... from ..... to ..... feet  
..... inch diameter ..... from ..... to ..... feet

Describe and show depth of shoe, plug, adapter, liner or other details: .....

9. Perforated Casings or Screens:

**No casing - pit** ..... from ..... to .....  
(Number per foot and size of perforations, or describe screen)  
..... from ..... to .....  
..... from ..... to .....  
..... from ..... to .....

10. Log of Well: (Describe each stratum or formation clearly, indicate if water bearing, and give thickness and depth as indicated.)

MATERIAL	Thickness (Feet)	Depth to Bottom (Feet)
Not available		

If log of well is not available, give name and address of driller. Albany Sand & Gravel, Albany

11. Infiltration Trench: Covered or open .....

Dimensions: Length ..... ft. Minimum depth ..... ft. Maximum depth ..... ft.

Bottom width ..... ft. Discharge ..... g.p.m. Date of test .....

12. Tunnel: Type of lining .....

Dimensions: .....  
(Length, course, and cross sectional size)

Position of water bearing stratum with reference to portal of tunnel .....

Log of tunnel: (Preceding table for log of well may be used, if desired. Give footage from portal and character of materials, as pertinent.)

13. Pumping Equipment:

(a) Pump 3<sup>rd</sup> Wyss centrifugal ..... Capacity 400 g.p.m.

(Make, type and size)

(b) Motor 15 H.P. electric .....

(Type and horsepower)

14. Location of area irrigated or to be irrigated, or place of use if for purposes other than irrigation.

Township North or South	Range E. or W. of Willamette Meridian	Section	Forty-acre Tract	Number Acres To Be Irrigated	Date of Reclamation
10 S	2 W	32	SW $\frac{1}{4}$ of NE $\frac{1}{4}$	7.0	1944
10 S	2 W	32	SE $\frac{1}{4}$ of NE $\frac{1}{4}$	0.7	1944
10 S	2 W	32	NE $\frac{1}{4}$ of SE $\frac{1}{4}$	1.7	1944
10 S	2 W	32	NW $\frac{1}{4}$ of SE $\frac{1}{4}$	22.6	1944
				32.0	

15. If the ground water supply is supplemental to an existing water supply, identification of any application for a permit, permit, certificate or adjudicated right to appropriate water made or held by the registrant.



RECEIVED

NOV 1 1956

STATE ENGINEER  
SALEM, OREGON

REGISTRATION NO. GR-167

Registration Statement

CERTIFICATE NO. GR-272

OF CLAIMANT OF RIGHT TO APPROPRIATE GROUND WATER

(Under Chapter 708, Oregon Laws 1955.)

TO THE STATE ENGINEER OF OREGON:

I, Flagmann Farms

of Rt. 2, Box 487, Albany County of Linn

State of Oregon do hereby make application for a certificate of registration as evidence of a right to appropriate ground water.

1. Source from which water is withdrawn is Pump Well No. 6  
(Flowing well, pump well, infiltration trench, or tunnel)

2. Location is: 8 miles East of Albany, Oregon  
(Approximate distance and direction from nearest city or town)

and is more particularly described as follows:

(a) N. 25° 15' W. 34.5 chains from the NE corner of the John A. Powell, D.L.C. 38,  
(Give distance and bearing to corner of section or other legal subdivision) T 11 S, R 2 W.

being within NW 1/4 of SE 1/4 of Sec. 32, Twp. 10 S, Rge. 2 W  
(Smallest legal subdivision) (N. or S.) (E. or W.)

or (b) within limits of recorded platted property, town or city:

(Name of plat or addition)

County of Linn  
(If within city or town, give name)

3. Construction Work was begun on 1938; was completed on 1938  
(Date) (Date)

and the ground water claimed was first used for the purposes set out below on 1938  
(Date)

since which time the water has been used continuously  
(Continuously or intermittently)

from 1938 to present time  
(Date) (Date)

4. Quantity of water claimed and used is 100 gallons per minute; 20 acre feet per year.

5. Purpose or Purposes for which water is used manufacturing (mint still)

(Domestic, irrigation, municipal, manufacturing, industrial, etc.)

6. Description of Well: Depth 30 feet. Type Drilled  
(Dug or drilled)

diameter 4 inches. Elevation of ground at well site 250 feet, mean sea level.  
(As near as known)

Depth to water table 10 feet.

7. Capacity of Well: 125 g.p.m. with 25 feet drawdown.




(Date)

Water is controlled by Cap. valve, etc.  
(Cap. valve, etc.)

GR-272 T



8. Casing: (Give diameter, commercial specifications and depth below ground surface of each casing size.)

4 inch diameter steel from 0 to 30 feet  
 inch diameter from to feet  
 inch diameter from to feet  
 inch diameter from to feet

Describe and show depth of shoe, plug, adapter, liner or other details:

9. Perforated Casings or Screens:

Bottom 5 feet of casing perforated from to  
 (Number per foot and size of perforations, or describe screen)  
 from to  
 from to  
 from to

10. Log of Well: (Describe each stratum or formation clearly, indicate if water bearing, and give thickness and depth as indicated.)

MATERIAL	Thickness (Feet)	Depth to Bottom (Feet)
Not available		


11. **Infiltration Trench:** Covered or open \_\_\_\_\_  
 Dimensions: Length \_\_\_\_\_ ft. Minimum depth \_\_\_\_\_ ft. Maximum depth \_\_\_\_\_ ft.  
 Bottom width \_\_\_\_\_ ft. Discharge \_\_\_\_\_ g.p.m. Date of test \_\_\_\_\_

12. **Tunnel:** Type of lining \_\_\_\_\_  
 Dimensions: \_\_\_\_\_  
(Length, course, and cross sectional size)  
 Position of water bearing stratum with reference to portal of tunnel \_\_\_\_\_

Log of tunnel: (Preceding table for log of well may be used, if desired. Give footage from portal and character of materials, as pertinent.)


13. **Pumping Equipment:**  
 (a) Pump 2" Fairbank Morse Centrifugal Capacity 250 g.p.m.  
(Make, type and size)  
 (b) Motor 10 H. P. Electric  
(Type and horsepower)

14. Location of area irrigated or to be irrigated, or place of use if for purposes other than irrigation.

Township North or South	Range E. or W. of Willamette Meridian	Section	Forty-acre Tract	Number Acres To Be Irrigated	Date of Reclamation
			<i>Manufacturing use</i>		<i>1938</i>

15. If the ground water supply is supplemental to an existing water supply, identification of any application for a permit, permit, certificate or adjudicated right to appropriate water made or held by the registrant.

Township 10 S Range 2 W , W.M.  
North

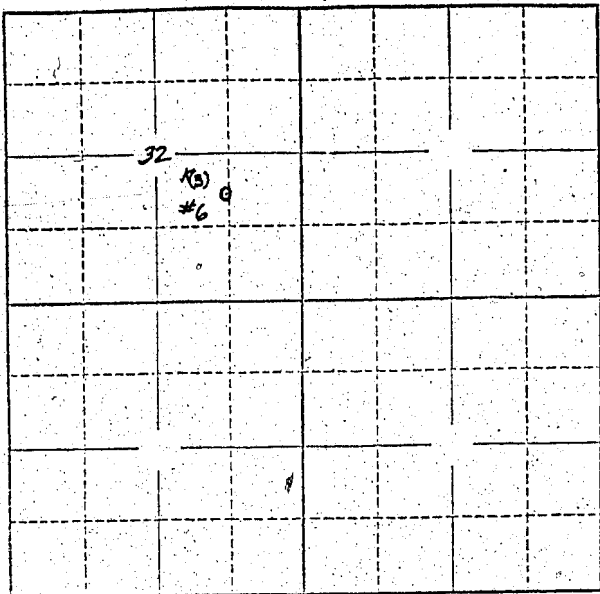

Locate well and acreage of irrigated land on plat.  
Scale: 2" = 1 Mile

STATE OF OREGON }  
County of Linn } ss.

I, Flagman Farms being first duly sworn, do hereby certify that I have read the foregoing Registration Statement and that all of the items therein contained are true to the best of my knowledge and belief.

Subscribed and sworn to before me this 19<sup>th</sup> day of October, 1956  
*Flagman Farms* (Signature of Registrant)  
*R.M. Russell Clerk*  
*By Mrs. Margaret* Deputy

My commission expires \_\_\_\_\_  
(SEAL)

**CERTIFICATE OF REGISTRATION**

STATE OF OREGON }  
County of Marion } ss.

This is to certify that the foregoing Registration Statement was received in the office of the State Engineer on the 26th day of April, 1956, at \_\_\_\_\_ 8 o'clock A.M. and has been duly recorded in said office in Book No. 2 of Registration Statements on page GR-272-H.

~~Construction shall be completed by X-X-X-X-X-X-X-X-X-X, 1956, and the water completely supplied to the farm by X-X-X-X-X-X-X-X-X-X.~~

Witness my hand this 15th day of January, 1957  
*Lewis A. Stanley*  
 (State Engineer)

By \_\_\_\_\_ (Deputy)  
 GR-272 W