

RECEIVED
JUN 11 1953
STATE ENGINEER
SALEM, OREGON

Registration No. GR 1671

Certificate No. GR 1622

Registration Statement

OF CLAIMANT OF RIGHT TO APPROPRIATE GROUND WATER

Registration Statement is made
by Robert I Swan, Administrator
for the Rachel Swan Estate

TO THE STATE ENGINEER OF OREGON:

I, Rachel Swan Estate
of Route 2 Junction City County of Lane
(Mailing address)

State of Oregon, do hereby make application for a certificate of registration as evidence
of a right to appropriate ground water.

1. Source from which water is withdrawn is Pump Well
(Flowing well, pump well, infiltration trench, or tunnel)

2. Location is: 4 miles South East of Junction City
(Approximate distance and direction from nearest city or town)

and is more particularly described as follows: 1200 Feet North of The Section

(a) Line's South Corner Between Section 10 & Section 11
(Give distance and bearing to corner of section or other legal subdivision)

being within SW 1/4 of Sec 11 of Sec. 11 Twp. 16S Rge. 4W
(Smallest legal subdivision) (S. or S.) (E. or W.)

or (b) within limits of recorded platted property, town or city:

in Lot _____, Block _____ of _____
(Name of plat or addition)

County of _____
(If within city or town, give name)

3. Construction Work was begun on 1942; was completed on 1942
(Date) (Date)

and the ground water claimed was first used for the purposes set out below on 1942
(Date)

since which time the water has been used Continuously
(Continuously or intermittently)

from May to Oct
(Date) (Date)

4. Quantity of water claimed and used is 200 gallons per minute; 3 7/8 acre
feet per year.

5. Purpose or Purposes for which water is used Farm Irrigation

(Domestic, irrigation, municipal, manufacturing, industrial, etc.)

6. Description of Well: Depth 30 feet. Type Driven Pipe
(Dug or drilled)

diameter 6 inches. Elevation of ground at well site _____ feet, mean sea level.

Depth to water table 8 feet.
(As near as known)

7. Capacity of Well: _____ g.p.m. with _____ feet drawdown.

_____ g.p.m. with _____ feet drawdown.

Date of test No Test


If Flowing Well: Measured discharge _____ g.p.m. on _____
(Date)

Shut-in pressure at ground surface _____ lbs. per sq. in. on _____
(Date)

Water is controlled by _____
(Cap, valve, etc.)

Well is located on the line between the SE 1/4
SE 1/4 corner of section 10 & the SW 1/4 SW 1/4 corner
of section 11

Township 16.5 Range 4W W.M.
North

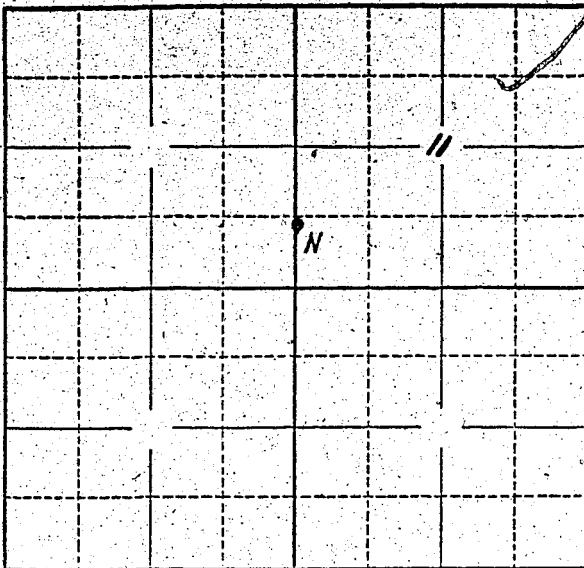

Locate well and acreage of irrigated land on plat.
Scale: 2" = 1 Mile

STATE OF OREGON

County of Lane } ss.

I, Robert J. Swan, being first duly sworn, do hereby certify that I have read the foregoing Registration Statement and that all of the items therein contained are true to the best of my knowledge and belief.

Robert J. Swan
(Signature of Registrant)

Subscribed and sworn to before me this 25 day of April, 1958

My commission expires My Commission Expires Jan. 21, 1959

[Signature]
(Notary Public)

(SEAL)

CERTIFICATE OF REGISTRATION

STATE OF OREGON

County of Marion } ss.

This is to certify that the foregoing Registration Statement was received in the office of the State Engineer on the 4th day of June, 1958, at 8:00 o'clock A.M. and has been duly recorded in said office in Book No. 8 of Registration Statements on page GR-1622

Witness my hand this 7th day of January, 1959

Laura A. Stanley
(State Engineer)

By _____ (Deputy)

\$15.00

GR - 1622