

RECEIVED
STATE ENGINEER
SAINT

Registration No. GR 1674
Certificate No. GR 1624

Registration Statement

OF CLAIMANT OF RIGHT TO APPROPRIATE GROUND WATER

TO THE STATE ENGINEER OF OREGON:

I, C. M. and Ella Bryant

of Rt. 2, Box 180, Lebanon County of Linn
(Mailing address)

State of Oregon, do hereby make application for a certificate of registration as evidence of a right to appropriate ground water.

1. Source from which water is withdrawn is pump well
(Flowing well, pump well, infiltration trench, or tunnel)

2. Location is: 1 mile north of Lebanon, Oregon
(Approximate distance and direction from nearest city or town)

and is more particularly described as follows:

(a) S. 77° W. 50.25 chains from NE corner of John H. Settle DLC 65
(Give distance and bearing to corner of section or other legal subdivision)

being within SE 1/4 of SW 1/4 of Sec. 34, Twp. 11 S, Rge. 2 W
(Smallest legal subdivision) (N. or S.) (E. or W.)

or (b) within limits of recorded platted property, town or city:

in Lot _____, Block _____ of _____
(Name of plat or addition)

County of Linn
(If within city or town, give name)

3. Construction Work was begun on October 1954; was completed on October 1954
(Date) (Date)

and the ground water claimed was first used for the purposes set out below on June 1955
(Date)

since which time the water has been used continuously
(Continuously or intermittently)

from June 1955 to present time
(Date) (Date)

4. Quantity of water claimed and used is 175 gallons per minute; 75.0 acre feet per year.

5. Purpose or Purposes for which water is used Irrigation

(Domestic, irrigation, municipal, manufacturing, industrial, etc.)

6. Description of Well: Depth 118 feet. Type Drilled
(Dug or drilled)

diameter 6 inches. Elevation of ground at well site 325 feet, mean sea level.
(As near as known)

Depth to water table 10 feet.

7. Capacity of Well: 220 g.p.m. with 50 feet drawdown.

_____ g.p.m. with _____ feet drawdown.

Date of test June 1955

If Flowing Well: Measured discharge _____ g.p.m. on _____
(Date)

Shut-in pressure at ground surface _____ lbs. per sq. in. on _____
(Date)

Water is controlled by _____
(Cap, valve, etc.)

8. Casing: (Give diameter, commercial specifications and depth below ground surface of each casing size.)

6 inch diameter **steel casing** from **0** to **118** feet
 inch diameter from to feet
 inch diameter from to feet
 inch diameter from to feet

Describe and show depth of shoe, plug, adapter, liner or other details:

9. Perforated Casings or Screens:

Slot perforations from **65** to **118**
(Number per foot and size of perforations, or describe screen)
 from to
 from to
 from to

10. Log of Well: (Describe each stratum or formation clearly, indicate if water bearing, and give thickness and depth as indicated.)

MATERIAL	Thickness (Feet)	Depth to Bottom (Feet)
Not available		

If log of well is not available, give name and address of driller. Bob White, Lebanon, Oregon

11. Infiltration Trench: Covered or open _____

Dimensions: Length _____ ft. Minimum depth _____ ft. Maximum depth _____ ft.

Bottom width _____ ft. Discharge _____ g.p.m. Date of test _____

12. Tunnel: Type of lining _____

Dimensions: _____
(Length, course, and cross sectional size)

Position of water bearing stratum with reference to portal of tunnel _____

Log of tunnel: (Preceding table for log of well may be used, if desired. Give footage from portal and character of materials, as pertinent.)

13. Pumping Equipment:

(a) Pump Fairbanks Morse 4" turbine Capacity 180 g.p.m.
(Make, type and size)


(b) Motor 15 H. P. electric
(Type and horsepower)

14. Location of area irrigated or to be irrigated, or place of use if for purposes other than irrigation.

Township North or South	Range E. or W. of Willamette Meridian	Section	Forty-acre Tract	Number Acres To Be Irrigated	Date of Reclamation
11 S	2 W	34	SE $\frac{1}{4}$ of SW $\frac{1}{4}$	21.7	June 1955
11 S	2 W	34	SW $\frac{1}{4}$ of SE $\frac{1}{4}$	8.3	" "
				30.0	

15. If the ground water supply is supplemental to an existing water supply, identification of any application for a permit, permit, certificate or adjudicated right to appropriate water made or held by the registrant.

Township 11 S Range 2 W W.M.
North

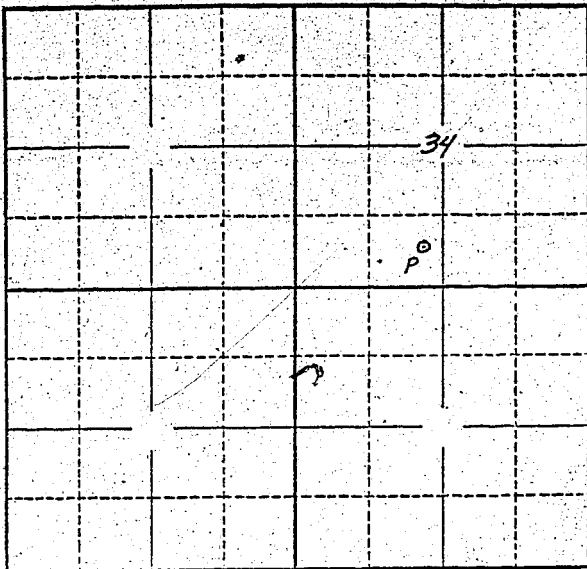

Locate well and acreage of irrigated land on plat.
Scale: 2" = 1 Mile

STATE OF OREGON

County of Linn } ss.

I, C. M. and Ella Bryant, being first duly sworn, do hereby certify that I have read the foregoing Registration Statement and that all of the items therein/contained are true to the best of my knowledge and belief.

C. M. Bryant
(Signature of Registrant)

Subscribed and sworn to before me this 3rd day of June, 1958

Ella Bryant
(Signature of Registrant)
[Signature]
(Signature of Notary)

My commission expires Nov. 1, 1959

(SEAL)

CERTIFICATE OF REGISTRATION

STATE OF OREGON

County of Marion } ss.

This is to certify that the foregoing Registration Statement was received in the office of the State Engineer on the 6th day of June, 1958, at 9:00 o'clock A. M. and has been duly recorded in said office in Book No. 8 of Registration Statements on page GR-1624

Witness my hand this 7th day of January, 1959

[Signature]
(State Engineer)

By _____ (Deputy)