

RECEIVED  
MAY 9 1958  
STATE ENGINEER  
SALEM, OREGON

Registration No. GR - 1676  
Certificate No. GR - 1626

### Registration Statement

#### OF CLAIMANT OF RIGHT TO APPROPRIATE GROUND WATER

TO THE STATE ENGINEER OF OREGON:

I, Alvin Woodruff and Edna Woodruff, husband and wife

of Box 2, Harbor, Oregon County of Clatsop

State of Oregon do hereby make application for a certificate of registration as evidence of a right to appropriate ground water.

1. Source from which water is withdrawn is Pump Well  
(Flowing well, pump well, infiltration trench, or tunnel)

2. Location is: 1 1/2 mile from Harbor, Oregon  
(Approximate distance and direction from nearest city or town)

and is more particularly described as follows:

(a) 1480 feet West and 250 feet South of NE corner Section 16  
(Give distance and bearing to corner of section or other legal subdivision)

being within NW 1/4 NE 1/4 of Sec. 16, Twp. 41 South, Rge. 13 West  
(Smallest legal subdivision) (N. or S.) (E. or W.)

or (b) within limits of recorded platted property, town or city:

in Lot \_\_\_\_\_, Block \_\_\_\_\_ of \_\_\_\_\_  
(Name of plat or addition)

County of \_\_\_\_\_  
(If within city or town, give name)

3. Construction Work was begun on UNKNOWN; was completed on 1944  
(Date) (Date)

and the ground water claimed was first used for the purposes set out below on 1944  
(Date)

since which time the water has been used Continuously  
(Continuously or intermittently)

from 1944 to 1958  
(Date) (Date)

4. Quantity of water claimed and used is 110 gallons per minute; \_\_\_\_\_ acre feet per year.

5. Purpose or Purposes for which water is used Irrigation

(Domestic, irrigation, municipal, manufacturing, industrial, etc.)

6. Description of Well: Depth 26 feet. Type Dug  
(Dug or drilled)

diameter 5' x 6' inches. Elevation of ground at well site 50 feet, mean sea level.  
(As near as known)

Depth to water table 12 feet.

7. Capacity of Well: 110 g.p.m. with 25 feet drawdown.

\_\_\_\_\_ g.p.m. with \_\_\_\_\_ feet drawdown.

Date of test Have pumped dry in two hours during dry periods for two years

If Flowing Well: Measured discharge \_\_\_\_\_ g.p.m. on \_\_\_\_\_  
(Date)


Shut-in pressure at ground surface \_\_\_\_\_ lbs. per sq. in. on \_\_\_\_\_  
(Date)

Water is controlled by \_\_\_\_\_  
(Cap, valve, etc.)





Township 41S Range 13W, W.M.  
North

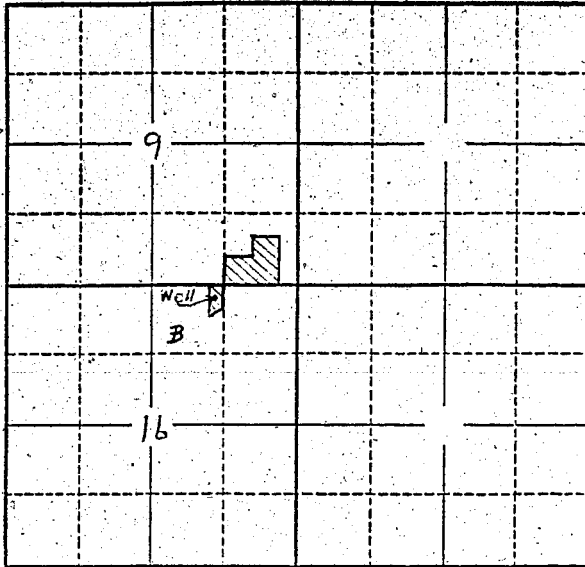

Locate well and acreage of irrigated land on plat.  
Scale: 2" = 1 Mile

STATE OF OREGON

County of Curry } ss.

I, Alvin Woodruff, being first duly sworn, do hereby certify that I have read the foregoing Registration Statement and that all of the items therein contained are true to the best of my knowledge and belief.

Subscribed and sworn to before me this 7th day of May, 1958.

My commission expires 1/4/61

Alvin Woodruff  
(Signature of Registrant)

Edna Woodruff

Sylvia J. Knox  
(Notary Public)

(SEAL)

**CERTIFICATE OF REGISTRATION**

STATE OF OREGON } ss.  
County of Marion

This is to certify that the foregoing Registration Statement was received in the office of the State Engineer on the 6th day of June, 1958, at 800 o'clock A. M. and has been duly recorded in said office in Book No. 8 of Registration Statements on page GR 1626

Witness my hand this 7th day of January, 1959

Laura A. Stanley  
(State Engineer)

By \_\_\_\_\_  
(Deputy)

#1500