

Registration Statement

OF CLAIMANT OF RIGHT TO APPROPRIATE GROUND WATER

TO THE STATE ENGINEER OF OREGON:

I, Luella M. Moses

of 1155 Madison St. Salem, Ore. County of Morion

State of Oregon, do hereby make application for a certificate of registration as evidence of a right to appropriate ground water.

1. Source from which water is withdrawn is Pump well
(Flowing well, pump well, infiltration trench, or tunnel)

2. Location is: 3/4 mile south of Jefferson
(Approximate distance and direction from nearest city or town)

and is more particularly described as follows:

(a) 1089 ft. East & 990 ft. south of N.W. Corner, Section 13
(Give distance and bearing to corner of section or other legal subdivision)

being within NW 1/4 of NW 1/4 of Sec. 13, Twp. 10 S, Rge. 3 W
(Smallest legal subdivision) (N. or S.) (E. or W.)

or (b) within limits of recorded platted property, town or city:

in Lot _____, Block _____ of _____
(Name of plat or addition)

(If within city or town, give name) County of _____

3. Construction Work was begun on October 1950; was completed on October 1950
(Date) (Date)

and the ground water claimed was first used for the purposes set out below on April 1951
(Date)

since which time the water has been used intermittently
(Continuously or intermittently)

from April to October
(Date) (Date)

4. Quantity of water claimed and used is 25 216 gallons per minute; 60.0 acre feet per year.

5. Purpose or Purposes for which water is used Irrigation

(Domestic, irrigation, municipal, manufacturing, industrial, etc.)

6. Description of Well: Depth 29 feet. Type Drilled
(Dug or drilled)

diameter 8 inches. Elevation of ground at well site 200' ± feet, mean sea level.
(As near as known)

Depth to water table 17 feet.

7. Capacity of Well: 700 g.p.m. with 7 feet drawdown.

_____ g.p.m. with _____ feet drawdown.


Date of test October 1950

If Flowing Well: Measured discharge _____ g.p.m. on _____
(Date)

Shut-in pressure at ground surface _____ lbs. per sq. in. on _____
(Date)

Water is controlled by _____
(Cap. valve, etc.)

Township 10 S Range 3 W W.M.
North

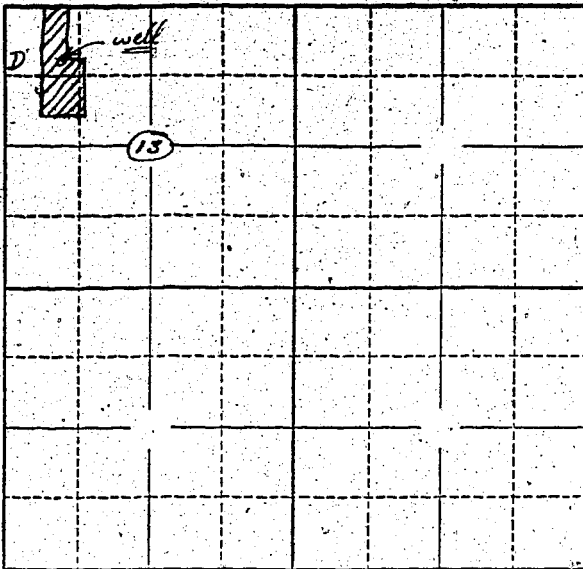

Locate well and acreage of irrigated land on plat.
Scale: 2" = 1 Mile

STATE OF OREGON

County of Marion

} ss.

I, Luella M. Moses, being first duly sworn, do hereby certify that I have read the foregoing Registration Statement and that all of the items therein contained are true to the best of my knowledge and belief.

Luella M. Moses
(Signature of Registrant)

Subscribed and sworn to before me this 9th day of June, 1958.

My commission expires 12th June 1961

Wm. S. Bartholomew
(Notary Public)

(SEAL)

CERTIFICATE OF REGISTRATION

STATE OF OREGON

County of Marion

} ss.

This is to certify that the foregoing Registration Statement was received in the office of the State Engineer on the 9th day of JUNE, 1958, at 10:30 o'clock A. M. and has been duly recorded in said office in Book No. 8 of Registration Statements on page GR-1628

Witness my hand this 7th day of January, 1959

\$1,500

Luella M. Moses
(State Engineer)

By _____
(Deputy)

GR-1628