

RECEIVED

MAY 1 1956

STATE ENGINEER
SALEM, OREGON

REGISTRATION NO. GR-168

Registration Statement

CERTIFICATE NO. GR-159

OF CLAIMANT OF RIGHT TO APPROPRIATE GROUND WATER

(Under Chapter 708, Oregon Laws 1955.)

TO THE STATE ENGINEER OF OREGON:

I, Ralph E. Reynolds

of Rt. 3, box 59 County of Washington

State of Oregon, do hereby make application for a certificate of registration as evidence of a right to appropriate ground water.

1. Source from which water is withdrawn is Pump Well
(Flowing well, pump well, infiltration trench, or tunnel)

2. Location is: 1/2 mi. So. and 1/2 mi. west of Sherwood, Oregon
(Approximate distance and direction from nearest city or town)

and is more particularly described as follows:

(a) S.E. corner 450 feet south and 300 feet east from center of Section 31
(Give distance and bearing to corner of section or other legal subdivision)

being within N 1/2 of NW 1/4 of SE 1/4 of Sec. 31, Twp. 2 S, Rge. 1 W
(Smallest legal subdivision) (N. or S.) (E. or W.)

or (b) within limits of recorded platted property, town or city:

in Lot _____, Block _____ of _____
(Name of plat or addition)

County of _____
(If within city or town, give name)

3. Construction Work was begun on Sept. 12, 1952, was completed on Sept. 27, 1952
(Date) (Date)

and the ground water claimed was first used for the purposes set out below on Domestic & field irrigation
(Date)

since which time the water has been used continuously
(Continuously or intermittently)

from Sept. 27, 1952 to still using
(Date) (Date)

4. Quantity of water claimed and used is 100 gallons per minute; _____ acre feet per year.

5. Purpose or Purposes for which water is used Domestic & field irrigation

(Domestic, irrigation, municipal, manufacturing, industrial, etc.)

6. Description of Well: Depth 215 feet. Type Drilled
(Dug or drilled)

diameter 6 inches. Elevation of ground at well site About 180 ft. feet, mean sea level.
(As near as known)

Depth to water table 30 feet.

7. Capacity of Well: 100 g.p.m. with 35 feet drawdown.

_____ g.p.m. with _____ feet drawdown.

Date of test Sept. 25, 1952

If Flowing Well: Measured discharge _____ g.p.m. on _____
(Date)

Shut-in pressure at ground surface _____ lbs. per sq. in. on _____
(Date)

Water is controlled by _____
(Cap, valve, etc.)

8. Casing: (Give diameter, commercial specifications and depth below ground surface of each casing size.)

6 inch diameter from Surface to 119 feet
 inch diameter from to feet
 inch diameter from to feet
 inch diameter from to feet

Describe and show depth of shoe, plug, adapter, liner or other details: Standard drive shoe
on end of pipe


9. Perforated Casings or Screens:

(Number per foot and size of perforations, or describe screen) from to
 from to
 from to
 from to

10. Log of Well: (Describe each stratum or formation clearly, indicate if water bearing, and give thickness and depth as indicated).

MATERIAL	Thickness (Feet)	Depth to Bottom (Feet)
Silt Brown	68	68
Blue Silt	20	88
Clay Blue	13	105
Brown Shale Broken	19	124
Dark Shale (very hard)	7	131
Brown Shale (solid)	12	143
Blue Shale broken	11	154
Dark Shale solid	26	180
Brown Shale (chocolate)	35	215
Water from broken shale 2nd crevice at 214 ft.		

Township 2 S Range 1 W W.M.
North Sec 31.

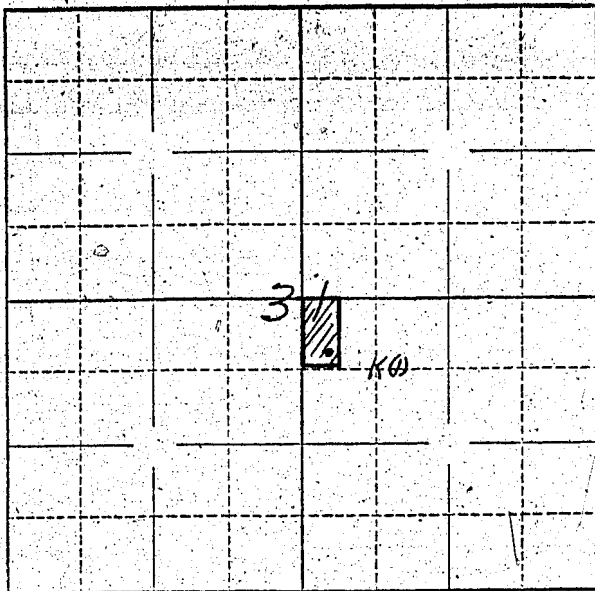

Locate well and acreage of irrigated land on plat.

Scale: $\frac{1}{4}$ " = 1 Mile
 $\frac{1}{8}$ " = 1/2 "

STATE OF OREGON

County of Washington } ss.

I, Ralph E. Reynolds, being first duly sworn, do hereby certify that I have read the foregoing Registration Statement and that all of the items therein contained are true to the best of my knowledge and belief.

Ralph E Reynolds
(Signature of Registrant)

Subscribed and sworn to before me this 30 day of April, 1956

My commission expires

NOTARY PUBLIC IN AND FOR THE STATE OF ORE.
MY COMMISSION EXPIRES NOVEMBER 22, 1957

[Signature]
(Notary Public)

(SEAL)

CERTIFICATE OF REGISTRATION

STATE OF OREGON

County of Marion } ss.

This is to certify that the foregoing Registration Statement was received in the office of the State Engineer on the 1st day of May, 1956, at 1:00 o'clock P. M. and has been duly recorded in said office in Book No. 1 of Registration Statements on page GR-159 C


Witness my hand this 8th day of October, 1956

Lewis A. Stanley
(State Engineer)

By _____ (Deputy)

GR-159 C