

Registration Statement

OF CLAIMANT OF RIGHT TO APPROPRIATE GROUND WATER

TO THE STATE ENGINEER OF OREGON:

I, Walter Schubert

of Rt. 2, Box 377, Boring County of Clackamas

State of Oregon do hereby make application for a certificate of registration as evidence of a right to appropriate ground water.

1. Source from which water is withdrawn is Pump Well

(Flowing well, pump well, infiltration trench, or tunnel)

2. Location is: 2 miles West of Boring

(Approximate distance and direction from nearest city or town)

and is more particularly described as follows:

(a) North 3° West, 2235' from SE Corner of Section 3

(Give distance and bearing to corner of section or other legal subdivision)

being within NE 1/4 NE 1/4 SE 1/4 of Sec. 3, Twp. 2S, Rge. 3E

(Smallest legal subdivision)

(S. or S.)

(E. or W.)

or (b) within limits of recorded platted property, town or city:

in Lot _____, Block _____ of _____

(Name of plat or addition)

County of Clack

(If within city or town, give name)

3. Construction Work was begun on April 1951; was completed on April 1951

(Date)

(Date)

and the ground water claimed was first used for the purposes set out below on July 1951

(Date)

since which time the water has been used Continuously throughout the summer

(Continuously or intermittently)

from July 1951 to Present

(Date)

(Date)

4. Quantity of water claimed and used is 60 gallons per minute; _____ acre feet per year.

5. Purpose or Purposes for which water is used Irrigation

(Domestic, irrigation, municipal, manufacturing, industrial, etc.)

6. Description of Well: Depth 210 feet. Type Drilled

(Dug or drilled)

diameter 6 inches. Elevation of ground at well site 567 feet, mean sea level.

(As near as known)

Depth to water table 190 feet.

7. Capacity of Well: _____ g.p.m. with _____ feet drawdown.

_____ g.p.m. with _____ feet drawdown.

Date of test _____

If Flowing Well: Measured discharge _____ g.p.m. on _____

(Date)


Shut-in pressure at ground surface _____ lbs. per sq. in. on _____

(Date)

Water is controlled by _____

(Cap, Valve, etc.)

Township 2S Range 3E W.M.
North

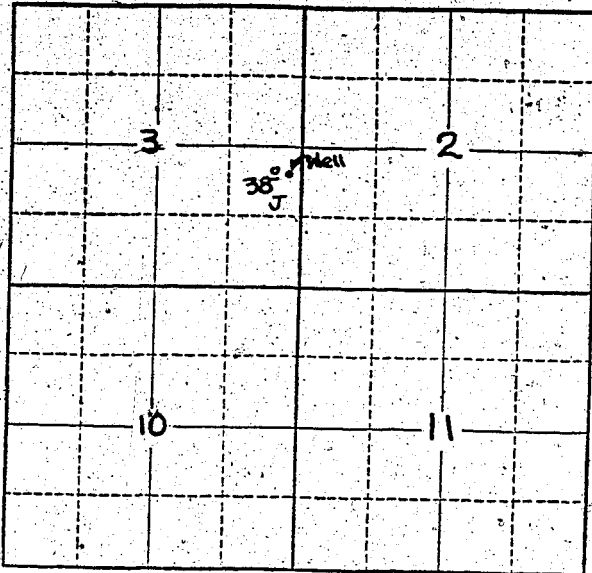

Locate well and acreage of irrigated land on plat.

Scale: 2" = 1 Mile

STATE OF OREGON

County of Cook } ss.

I, WALTER SHUBERT, being first duly sworn, do hereby certify that I have read the foregoing Registration Statement and that all of the items therein contained are true to the best of my knowledge and belief.

Walter Schubert
(Signature of Registrant)

Subscribed and sworn to before me this 8th day of APRIL, 1958.

My commission expires April 19, 1961

Walter Shedd
(Notary Public)

(SEAL)

CERTIFICATE OF REGISTRATION

STATE OF OREGON

County of Marion } ss.

This is to certify that the foregoing Registration Statement was received in the office of the State Engineer on the 9th day of June, 1958, at 8:00 o'clock A.M. and has been duly recorded in said office in Book No. 8 of Registration Statements on page GR-1634

Witness my hand this 7th day of January, 1959.

\$16.20

Lewis P. Stanley
(State Engineer)

By _____ (Deputy)

GR-1634